

WATER SERVICE RECORD

Name Richard Marvin

Service No. 41

Address 23 Robbins Road

Location

~~Repair - Renewal - NEW SERVICE~~

Comm 6-19-61


Date	Material	Amount	Total	Date	Amount
4-26-61	Labor	25.76		4-17-61	Deposit 100.00
	10% O.H.	2.58	28.34	4-19-61	Retreat 29.77
35'	3/4" Copper Tubing @.42		14.70		NON CHARGE 70.21
1	3/4" c x 1/2 I.W.H. Stop & Waste	6.17		4-26-61	Labor 5.24
3	Hrs. pippin Shovel @5.00	15.00		4-27-61	Labor 8.04
2	Hrs. Trucking @3.00	6.00			18' 3/4" Copper Tubing @.42 7.56
			70.21		1 3/4" Adapter 2.21
					1 1/2 Straight tailpiece .50
					1 1/2 Offset tailpiece .50
					16 x 3 Patch 16.00
					1 Hr. Trucking @3.00 3.00
					1 Hr. Pippin Shovel @5.00 5.00
					48.05

DATE _____

TOWN OF LEXINGTON — BOARD OF PUBLIC WORKS

WATER DIVISION

Sketch of Service Here

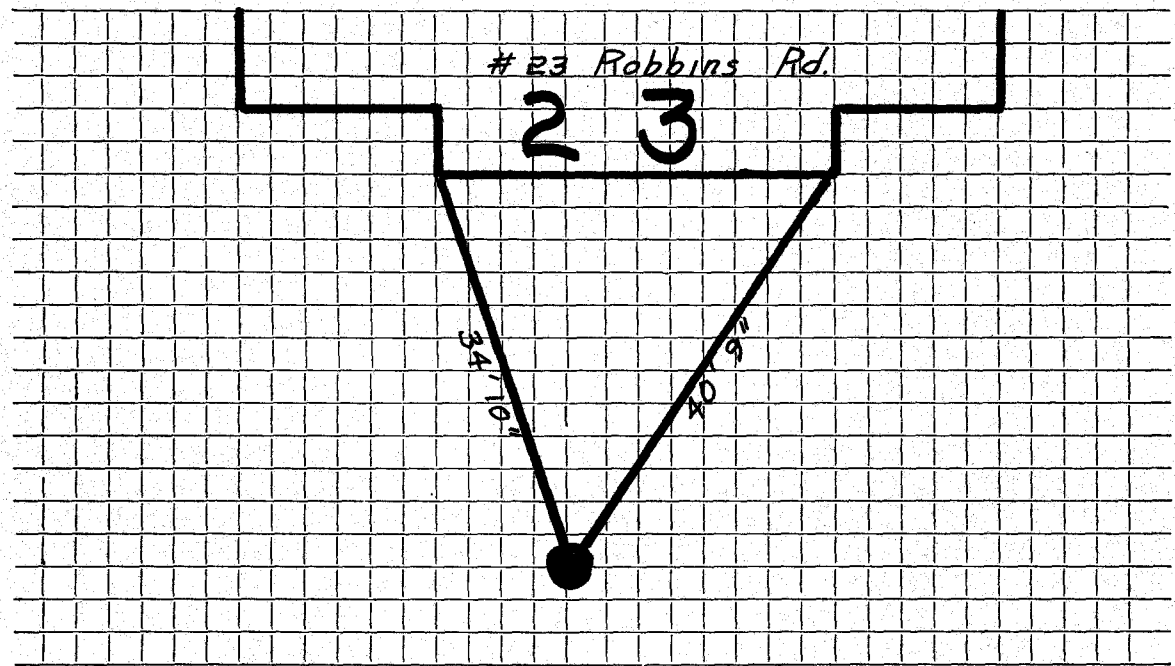

Connection made in Street. Work completed

Remarks:
.....
.....