

WATER SERVICE RECORD

# 4523

Name Wilfred D. Sampson

Service No. 285

Address 27 Robbins Road

Location Lexington, Mass.

~~REPAIR WORK~~ New Service

Com. 12-26-50


Date		Material	Amount	Total	Date		Amount
Oct. 20,	'50	Labor	1 35	1 35	Aug. 31	'50	15 00
		10% Overhead		14	Feb. 2	'51	4 12
		41' - 3/4" Copper Tubing @.32		13 12			No Charge
		1 - 3/4"C x 1/2" I.W.H. S&W		3 76	Oct. 20,	'50	Labor
		Trucking 1 hr. @.75		75			1 35
				19 12			18' - 3/4" Copper Tubing @.32
							5 76
							1 - 3/4"C Corp-cock
							3 60
							1 - 3/4"C x 3/4"C Curb-cock
							4 40
							1 - Box & Rod
							4 44
							1 - 1/2" Straight Tail Piece
							42
							1 - 1/2" Offset Tail Piece
							42
							Trucking 1 hr. @.75
							75
							21 14

Bills sent - 1-12-51

DATE \_\_\_\_\_

**TOWN OF LEXINGTON — BOARD OF PUBLIC WORKS**  
**WATER DIVISION**

Sketch of Service Here

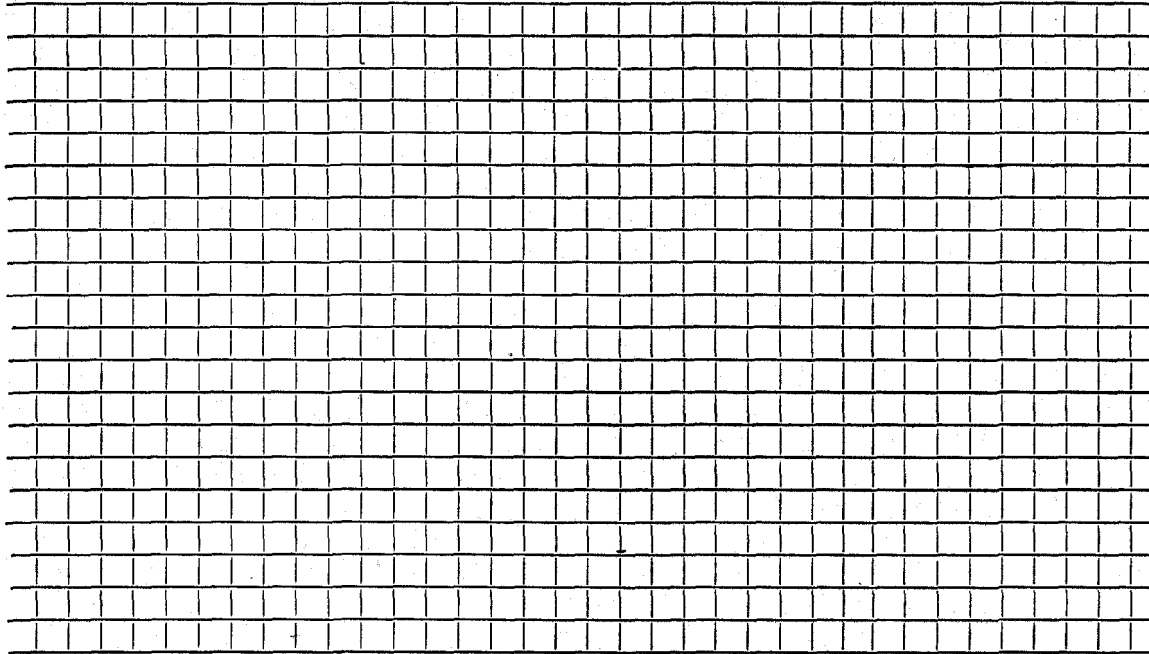

Connection made in ..... Street.      Work completed .....

Remarks: .....  
.....  
.....