

WATER SERVICE RECORD

Name James McDevitt

Service No. 405 (1953)

Address 31 Robbins Road

#7794

Location

~~Repair~~ - Renewal - ~~NEW SERVICE~~

Com. 5-3-54


Date	Material	Amount	Total	Date	Amount
3/26/54	Labor	31 25		12-23-53 Deposited	60 00
	10% overhead	3 13	34 38	5-3-54 Refunded	6 17
	42' 3/4" Copper tubing @ .35	14 70			<u>53 83</u>
	1-3/4" Cx 1/2 I.W.H. Stop & waste	4 00		3/26/54 Labor	47 00
	1 hr. trucking		75	18' 3/4" Copper tubing @ .35	6 30
			53 83	1-3/4" C. Corp cock	4 33
				1-3/4" Cx 3/4" C. Curb cock	4 67
				1- Box & rod	3 90
				1- 1/2 Offset tail piece	50
				1- 1/2 Straight tail piece	50
				1 hr. trucking	75
					<u>67 95</u>
				31 67	8' 3/4 Cop
					1- 3/4 Corp
					1- 3/4 Union

DATE \_\_\_\_\_

TOWN OF LEXINGTON — BOARD OF PUBLIC WORKS

WATER DIVISION

Sketch of Service Here

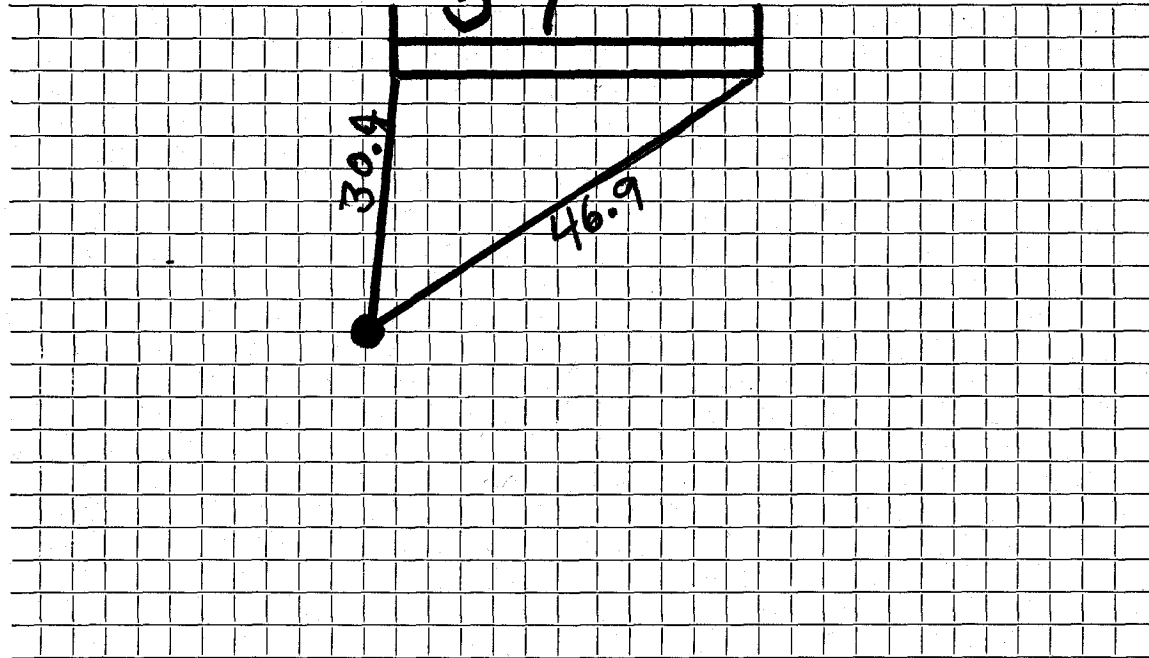

Connection made in ..... Street. Work completed .....

Remarks: .....  
.....  
.....