

WATER SERVICE RECORD

Name J. J. McSweeney

Service No. 361

Address 3/4 Robbins Rd.

Location Lexington

~~Renewal~~ - Renewal - ~~NEW SERVICE~~

Com. 11-23-53


Date	Material	Amount	Total	Date	Amount
10/8/53	Labor	3 50			
	10% overhead	35	3 85		
	40'-3/4" Copper Tubing @.3629		14 52	12-17-53	<i>no deposit Paid</i>
	1-3/4" C x 1/2 I.W.H. STOP & WASTE		4 00		NON CHARGE
	2 Hr. Littlefield Shovel @7.50		15 00	10/8/53	Labor 26 38
	1 Hr. Trucking		<u>75</u>	14'-3/4" Copper Tubing @.3629	5 08
			38 12	1-3/4" C. Adapter	1 95
				1-3/4" C x 3/4" C. Curb-cock	4 67
				1-Box & Rod	3 90
				1-1/2 straight tail piece	50
				1-1/2 offset tail piece	50
				1 Hr. Trucking	<u>75</u>
					43 73
					<i>bill sent 11-23-53</i>

DATE _____

TOWN OF LEXINGTON — BOARD OF PUBLIC WORKS

WATER DIVISION

Sketch of Service Here

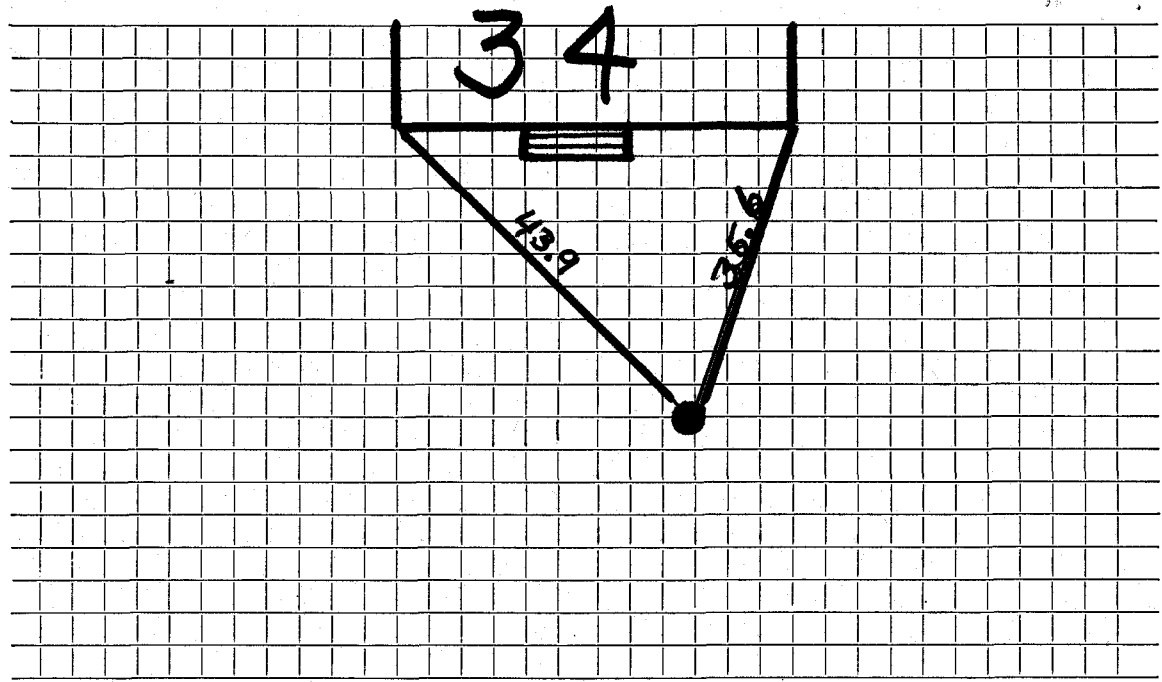

Connection made in Street. Work completed

Remarks:
.....
.....