

Name Barnhill, F. H.

Service No. ~~22~~ 2393⁸⁷

Address ~~18 Harvard St., Arlington~~

35 Robbins Rd.

Location 35 Robbins Road, Lexington

Kind of Pipe

Size

Size of Main

~~Repair - Renewal~~ - New Service

Location

Date	Material	Amount	Total	Date	Amount
7/15/36	3 hrs. labor @ 60¢	1 80		June 30 1936 Deposited July 10 1936 Add. Dep.	17 10
<i>Comm. 7-21-36 # 15.00</i>	10% Ovhd. on labor	18			90
	36' 1" C.L. Pipe @ 27¢	9 72			18 00
	3 1" L.L. Coup. @ 18¢	54			
	1 S. & W.	1 75			
			\$13 99		
	Chge. 36' @ 50¢ - \$18.00		\$18 00		
	Labor				

Outside:
Checked 10-23-91
3/4 Copper

Hadley Profs. Inc., Lexington

38
45
190
152
17.10

DATE June 30, 1936.

TOWN OF LEXINGTON—BOARD OF PUBLIC WORKS

WATER DIVISION

The undersigned applies for a supply of water at No. 35 Robbins Road St. and hereby agrees to comply with the rules and regulations as now, or at any future time, established by the Board of Selectmen.

Am't. of Estimate \$ _____


Owner F H Barnhill

Am't. Paid \$ _____

Address 18 Harvard St Cal

Builder _____

Sketch of Service Here

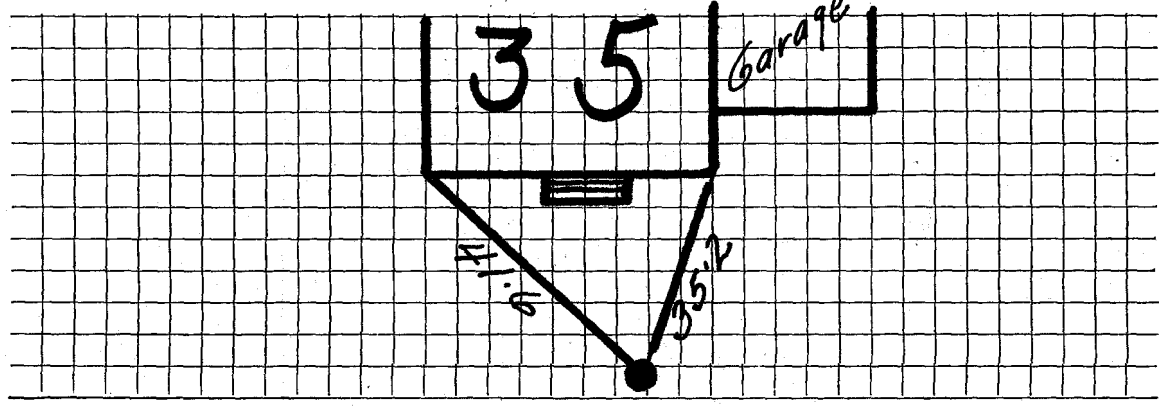

Connection made in _____ Street.

Work completed _____ 19

Remarks: