

WATER SERVICE RECORD

#6030
#6031
2

Name *Morris L. Schwisberg*

Service No.

Address # 38 Robbins Road

Location

~~REPAIR~~—Renewal—~~NEWS SERVICE~~ W.O. # 7875

W.O. # 6171 MAY 27 1969


Date		Material	Amount		Total		Date		Amount	
1/13/69		Labor	75	28			<i>1-9-69</i> <i>5-27-69</i>	<i>Deposit</i> <i>Returned</i>	500	00
		10% O.H.	7	53	82	81		<u>OUTSIDE</u>	399	04
	35'	3/4" Copperpipe .79			27	65	4/16/69	Labor	111	23
	1	3/4" Wheel Valve			9	30		31' 3/4" copperpipe .79	24	49
	2	Hrs. trucking 3.00			6	00		1/4" curb cock	11	30
	3	" shovel 6.50			19	50		1 ton cold patch	5	50
	2	" compressor 5.00			10	00		1/2 Yd. loam	3	50
	1	Yd. Loam			3	50		1/2 Lb. grass seed 1.10		55
	2	Lbs. seed 1.10			2	20		2 Ton hot top 5.80	11	60
					160	96		4 Hrs. trucking 3.00	12	00
								1 " "	1	50
								4 " Shovel 6.50	26	00
								1 " Compressor	5	00
								1 " Roller	3	00
								Trailer	2	00
									217	69

DATE _____

TOWN OF LEXINGTON — BOARD OF PUBLIC WORKS

WATER DIVISION

Sketch of Service Here

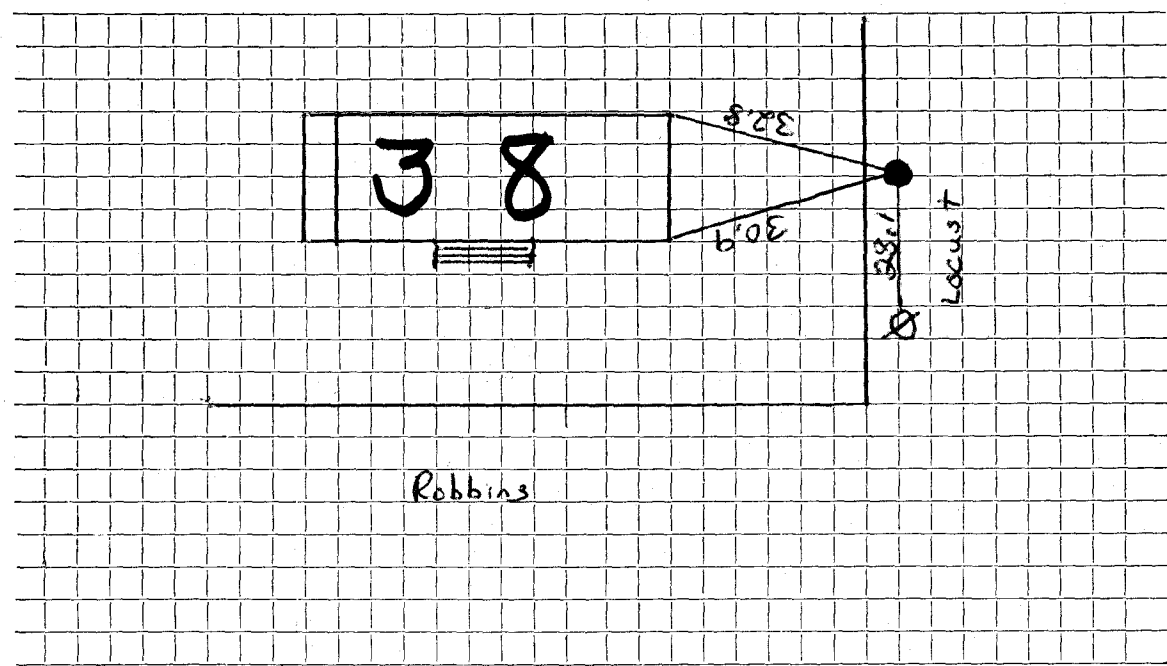

Connection made in Street. Work completed

Remarks:
.....
.....