

Name M. Bowman Judkins, Builder (Owner- Mr. Galt.)

Service No. ~~1937~~ #5

Address ~~6 Colony Road~~
4 Robbins Rd

2379

#4 Robbins Rd

Location Lot #16 Robbins Road

Kind of Pipe

Size

Size of Main

~~Repair - Renewal~~ - New Service

Location

Date	Material	Amount	Total	Date	Amount
Dec. 21 '36	Labor or sewer card			March 24 1937 Paid	20 50
<i>Call 2.23-1937</i>	41' 3/4" Copper Tub. @ 20¢		8 20		
	1 Stop and Waste		2. 00		
	Trucking		75		
			10 95		
	Say:				
	41' at 50¢		20 50		
	No Trench Repairs				
	Labor				

Hadley Press, Inc., Lexington

DATE _____

TOWN OF LEXINGTON—BOARD OF PUBLIC WORKS

WATER DIVISION

The undersigned applies for a supply of water at No. _____ St. and hereby agrees to comply with the rules and regulations as now, or at any future time, established by the Board of Selectmen.

Am't. of Estimate \$ _____


Owner _____

Am't. Paid \$ _____

Address _____

Builder _____

Sketch of Service Here

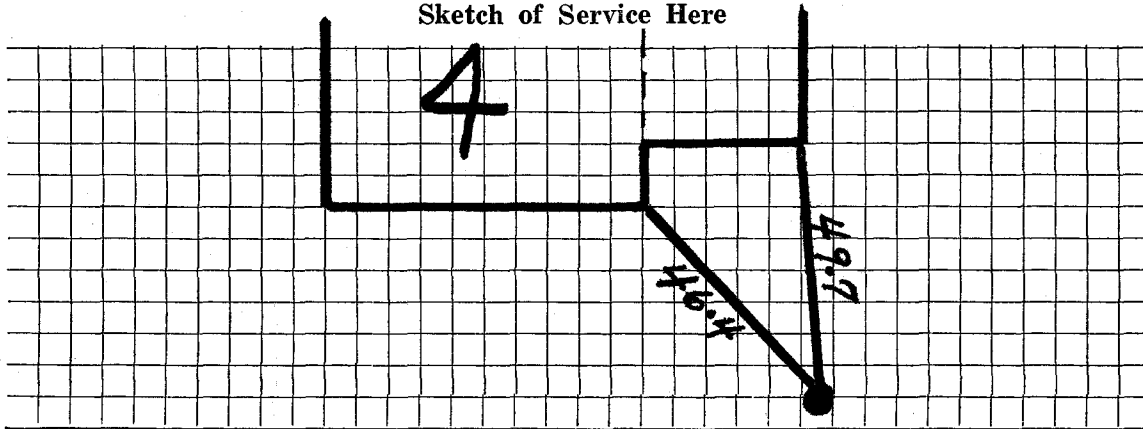

Connection made in _____ Street.

Work completed _____ 19

Remarks: