

WATER SERVICE RECORD

1408

Name Joseph H. Sweeney

Service No. 86

Address 50 Robbins Rd.

Location

Repair—Renewal—New Service

Com. 9-24-51


Date	Material	Amount	Total	Date	Amount
6-21-51	Labor	5 30	5 30	5-15-51	Deposited 60 40
	10% Overhead		53	9-24-51	Refunded 17 40
	50'- 3-4" Copper Tubing @ .326	16 30			42 60
	1- 3/4" C x 1/2 I.W.H S&W		4 00		No Charge
	1-3/4" C x 3/4"C Union (3 pts)		1 72	6-21-51	Labor 5 30
	2 Hrs. Littlefield Shovel		14 00		28'- 3/4" Copper Tubing @ .326 9 12
	1 Hr. Trucking		75		1- 3/4" C. Corp-Cock 4 33
			42 60		1- Box & Rod 4 68
					1- 3/4" C x 3/4" C. Curb-Cock 4 67
					1- 1/2 offset Tail Piece 50
					1- 1/2 straight tail piece 50
					2 Hrs. Littlefield Shovel 11 00
					1 Hr. Trucking 75
					43 85

DATE _____

TOWN OF LEXINGTON — BOARD OF PUBLIC WORKS

WATER DIVISION

Sketch of Service Here

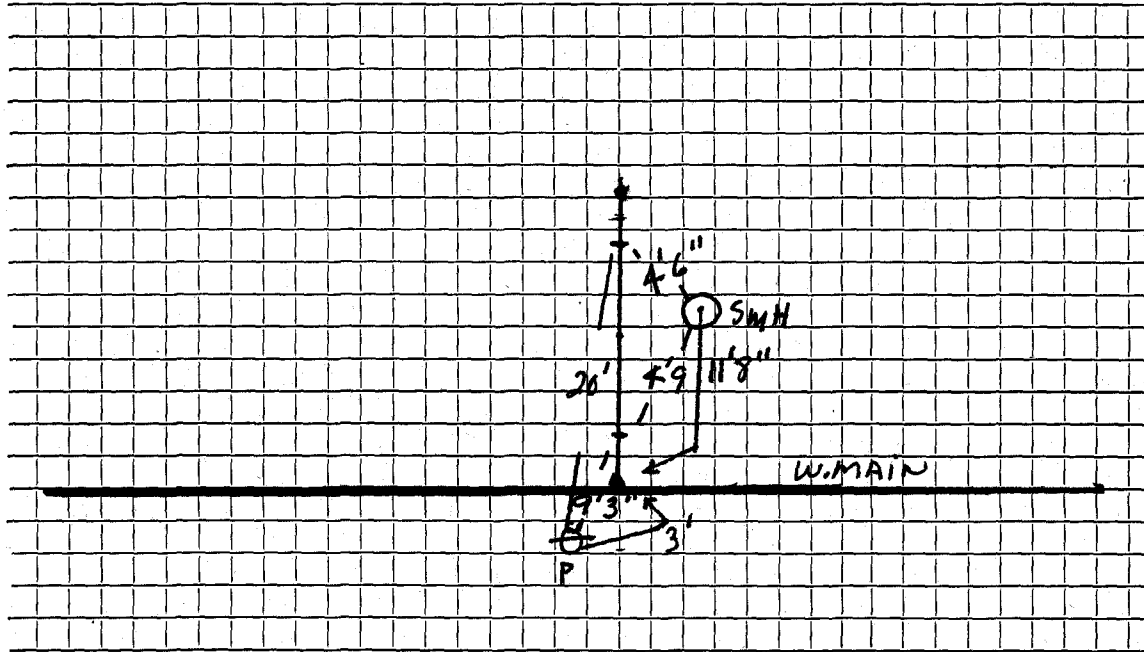

Connection made in Street. Work completed

Remarks: 2-3/4 UNIONS BRUCE MCKEE 10-16-90 CORP 3' DEEP