

Name Edwin H. Nelsen
 Address 34 Marlboro Road, Waltham.
~~88xRobbins Rd~~

Service No. 2396
#7064
#7101

66 Robbins Rd Location 66 Robbins Road

Kind of Pipe _____ Size _____ Size of Main _____

~~Repair - Renewal~~ - New Service _____ Location _____

Date	Material	Amount	Total	Date	Amount
	<u>Chargeable</u>				
3/6/42	1 hr.	60		<i>March 2nd, 1942 Deposited Return</i>	16.00
<i>com 4/6/42</i>	1 "	70	1 30		2.50
	10% Overhead		13		13.50
	42' 3/4" Copper tubing @ 21¢		8 82		
	1 3/4" C x 1/2" I.W.H.S.& W.		2 50		
	1 hr. trucking		75		
	Part of trench dug by owner		13 50		
	Not chargeable (Curb to Main)				
	Labor	6 10			
4 hrs.	compressor @ 2.25	9 00			
2 "	tractor @ 1.25	2 50			
2 "	trucking @ .75	1 50			
20'	3/4" Cop. tub. @ .21	4 20			
1	3/4" Corp. cock	2 25			
1	3/4" Curb cock	2 75			
1	3/4" Cop. union (3 parts)	1 31			
1	1 1/2" Labor Straight tailpiece	38			
1	1 1/2" offset tailpiece	38			
1	Box and rod	1 65			
		<u>32 02</u>			

Hadley Press, Inc., Lexington



68
23
91

DATE Feb 11, 1942

TOWN OF LEXINGTON—BOARD OF PUBLIC WORKS

WATER DIVISION

The undersigned applies for a supply of water at No. 66 Robbins Road St. and hereby agrees to comply with the rules and regulations as now, or at any future time, established by the Board of Selectmen.

Am't. of Estimate \$ 16⁰⁰

Owner Edwin A Nelson

Am't. Paid \$ _____


Address 34 Marlboro Rd

Builder _____

Waltham

*Edwin A Nelson
34 Marlboro Rd
Waltham, Mass*

Sketch of Service Here

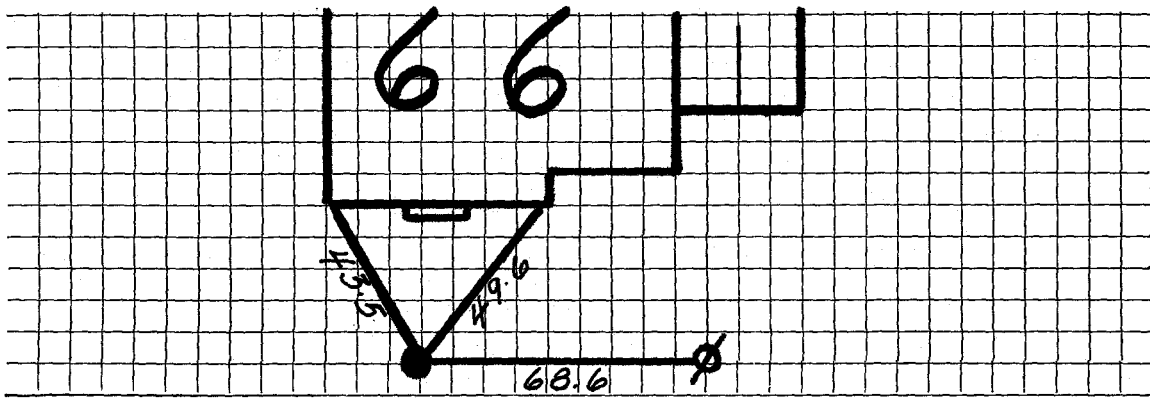

Connection made in _____ Street.

Work completed _____ 19

Remarks: