

Name F. Hedley Barnhill

Service No. ~~20~~ 2380

Address ~~14 Ashland Street, Arlington~~

459

7 Robbins Road

Location

~~6~~ Robbins Road

Kind of Pipe

Size

Size of Main

Repair—Renewal—New Service

Location

Date
1938

Material

Amount

Total

Date

Amount

5/24/38

2 hrs @ 60¢

1 20

1 20

May 16, 1938

Deposited

15 00

35' 3/4" C. Tubing @ 20¢

7 00

1 3/4" C. Union 2 part

1 10

1 1" Close Nipple

35

1 3.4" S. & W.

3 75

13 40

Flat Rate: \$15.00

Labor

Hedley Press, Inc., Lexington

DATE May 16, 1938

TOWN OF LEXINGTON—BOARD OF PUBLIC WORKS

WATER DIVISION

The undersigned applies for a supply of water at No. 3 Robbins Road St. and hereby agrees to comply with the rules and regulations as now, or at any future time, established by the Board of Selectmen.

Am't. of Estimate \$ 15— for 25' set back

Owner F. Hedley Barnhill


Am't. Paid \$ _____

Address 14 Ashland St

Builder Orman's Trench

Attingham Mass

Sketch of Service Here

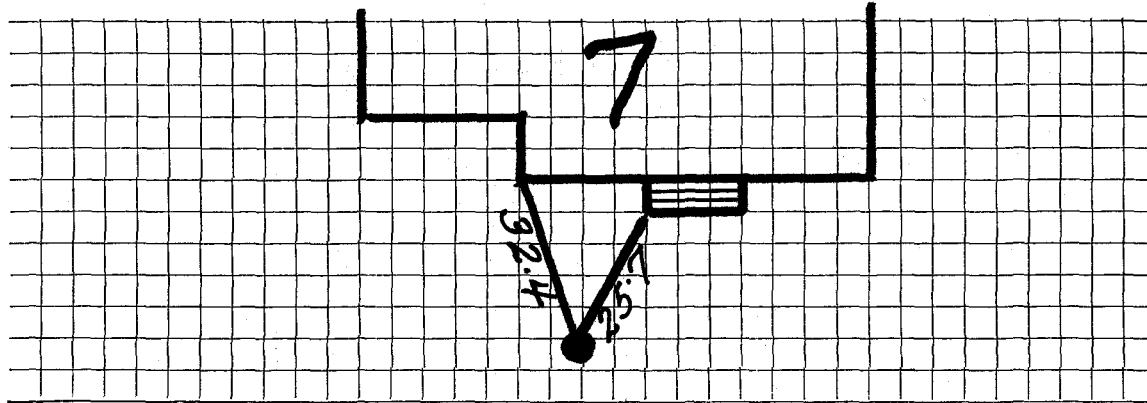

Connection made in _____ Street.

Work completed _____ 19

Remarks: