

## WATER SERVICE RECORD

Name Herbert Collins

Service No. 382

Address 76 Robbins Road

Location

~~Repair - Renewal~~ - New Service


Comm. 4/29/57

Date	Material	Amount	Total	Date	CURB TO MAIN	Amount
12/28/57	labor	16 47			labor	7 60
	10% overhead	1 65			55' 3/4" copper tubing @ .4396	24 18
			18 12		1 3/4" C. corp cock	4 64
90	3/4" copper tubing @ .4396		39 56		1 box & rod	4 62
1	3/4" Cx 1/2 IWH stop & waste		4 96		1 3/4" C. curb cock	5 94
3	trucking @ .75		2 25		2 hrs. Littlefield @ 8.50	17 00
2	hrs. Littlefield @ 8.50		17 00		3 hrs. Allis Chalmers @ 3.00	9 00
1	3/4" Union Parts		2 27			72 98
			84 16			
				12-12-56	Deposit	\$ 100 00
				4-29-57	Refund	15 84
						84 16

TOWN OF LEXINGTON — BOARD OF PUBLIC WORKS

WATER DIVISION

Sketch of Service Here

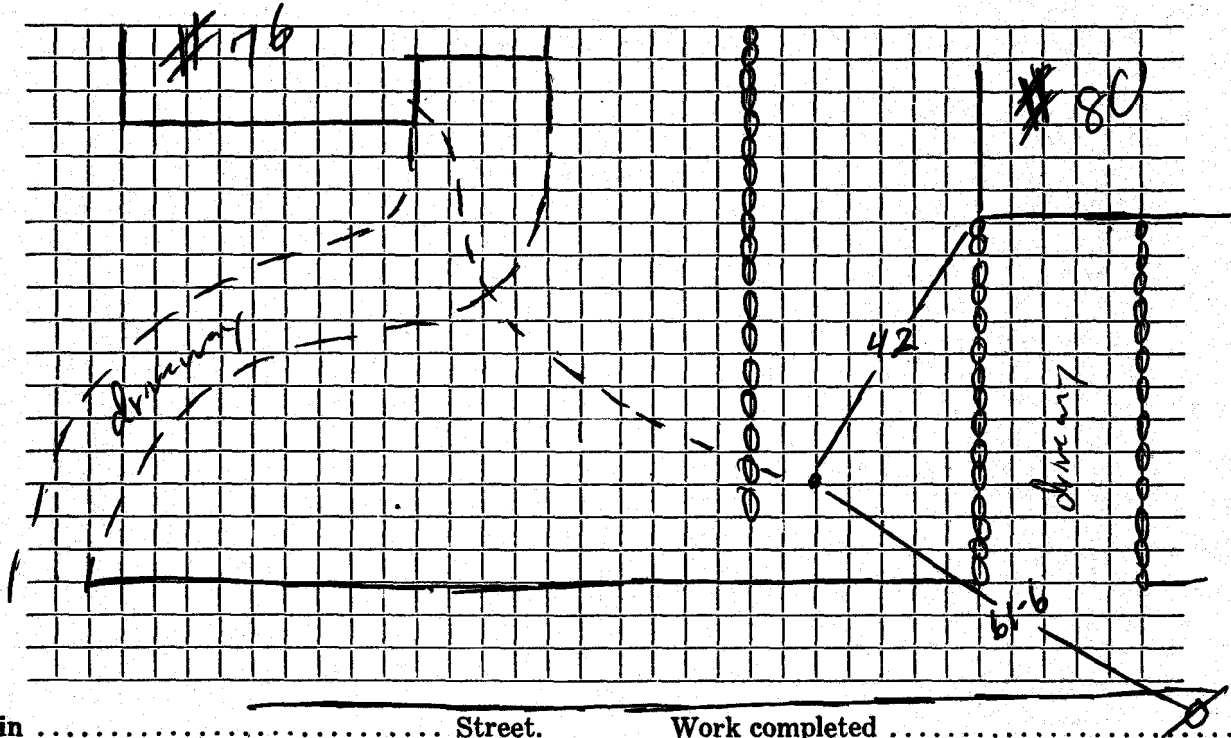

Connection made in ..... Street. Work completed .....

Remarks: .....

.....

.....