

Name M. M. Webb

Service No. ~~30~~ 2398

Address ~~483 Mass. Avenue~~

#5827

79 Robbins Rd

Location

79 Robbins Road

Kind of Pipe

Size

Size of Main

Repair—Renewal—New Service

Location

Date
1939

Material

Amount

Total

Date

Amount

August 21

2 hrs. @ 60¢

1 20

August 8, 1939 Deposited

18 00

Corr 9/10/39

36' 3/4" Copper Tubing @ 20¢

7 20

1 3/4" C x 1/2 I. Stop & Waste

3 75

2 hrs. Trucking @ 75¢

1 50

13 65

Charge Flat Rate: \$18.00

Labor

DATE August 8, 1939

TOWN OF LEXINGTON—BOARD OF PUBLIC WORKS

WATER DIVISION

The undersigned applies for a supply of water at No. 79 Tabbin Road St. and hereby agrees to comply with the rules and regulations as now, or at any future time, established by the Board of Selectmen.

Am't. of Estimate \$ _____


Owner M M Webb

Am't. Paid \$ _____

Address 483 Mass Ave

Builder _____

Sketch of Service Here

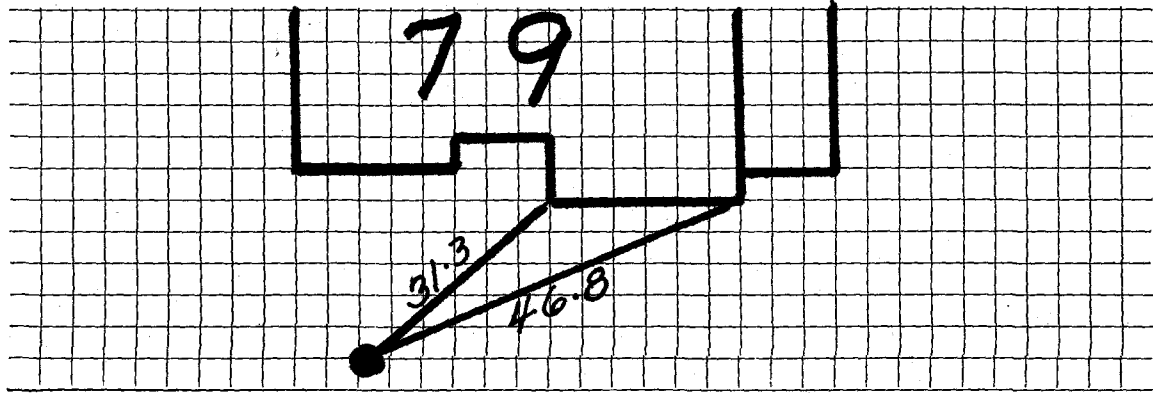

Connection made in _____ Street.

Work completed _____ 19

Remarks: