

WATER SERVICE RECORD

Name J. G. Realty Trust

Service No. 19

Address 80 Robbins Road

Location

~~Renewal~~ New Service #698 DeFlice #3407

DEC 3 1979

Date	Material	Amount	Total	Date	Amount
9-5-79	Labor	52.86		8-15-79	240.00
	10% O.H.	5.29	58.15		120.18
16'	3/4" Copper tubing @.94		15.04		119.82
1	3/4" Corp.		12.40		
1	3/4" Curb		17.73		
1	Box & Rod		13.50		
1	hr. Trucking		3.00		
			119.82		
10-2-79	44' 4" 3/4" Copper tubing				


* Applied to 842154
82018

DATE _____

TOWN OF LEXINGTON — BOARD OF PUBLIC WORKS

WATER DIVISION

Sketch of Service Here

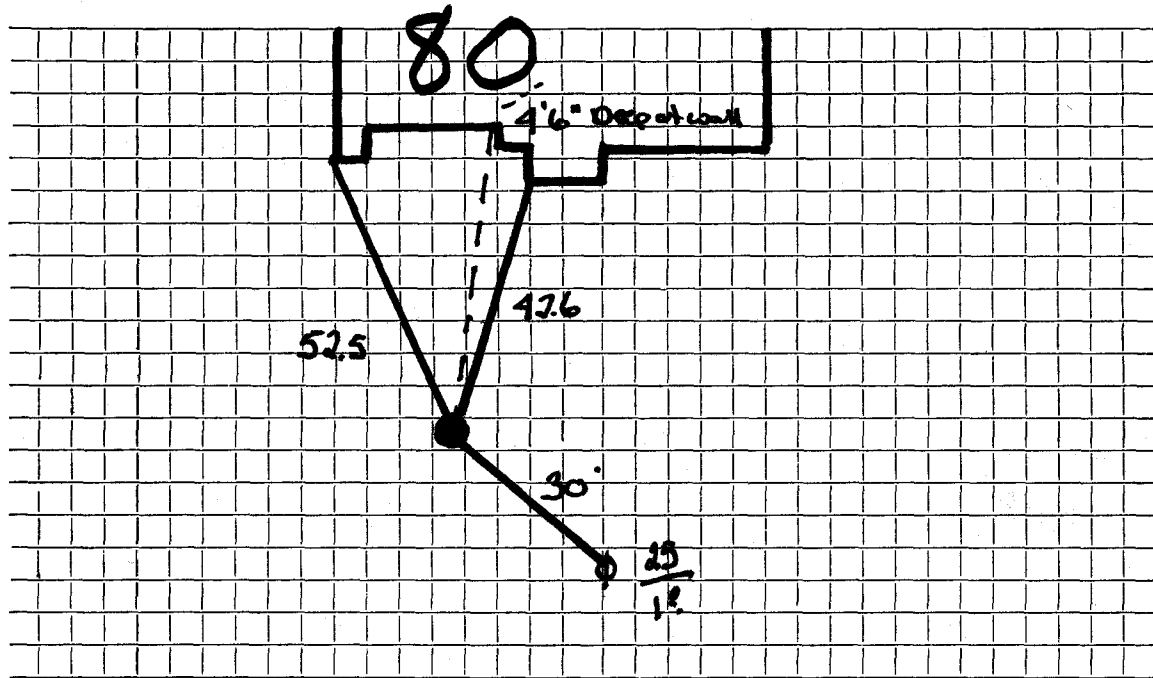

Connection made in Street. Work completed

Remarks:
.....
.....