

Name

James R. Smith

4425
Service No.

2399
31

Address

#86 Robbins Rd
Lot 36, ~~Richard Rd. & Tower St.~~

Location

86 Robbins Rd

Kind of Pipe

Size

Size of Main

~~Repair - Renewal~~ - New Service

Location

Date

Material

Amount

Total

Date

Amount

10/17/33-53' $\frac{3}{4}$ " C. Pipe @.15

\$7 95

AR 10/1/34

Com. 23.85 1 S & W

2 75

AR 10/1/34

11-21-33 Trucking

75

11 45

Labor on sewer slip

CHARGE 53' @ .45

\$23 85

\$23 85

Sept. 27, 1934 - Cash

23 85

Labor

Hadley Press, Inc.,
Huntington

DATE Oct. 16 1933

TOWN OF LEXINGTON—BOARD OF PUBLIC WORKS

WATER DIVISION

The undersigned applies for a supply of water at No. ^{Lot} 26 Richard Rd. & Tower St. and hereby agrees to comply with the rules and regulations as now, or at any future time, established by the Board of Selectmen.

Am't. of Estimate \$ _____


Owner

James Smith

Am't. Paid \$ _____

Address

Builder _____

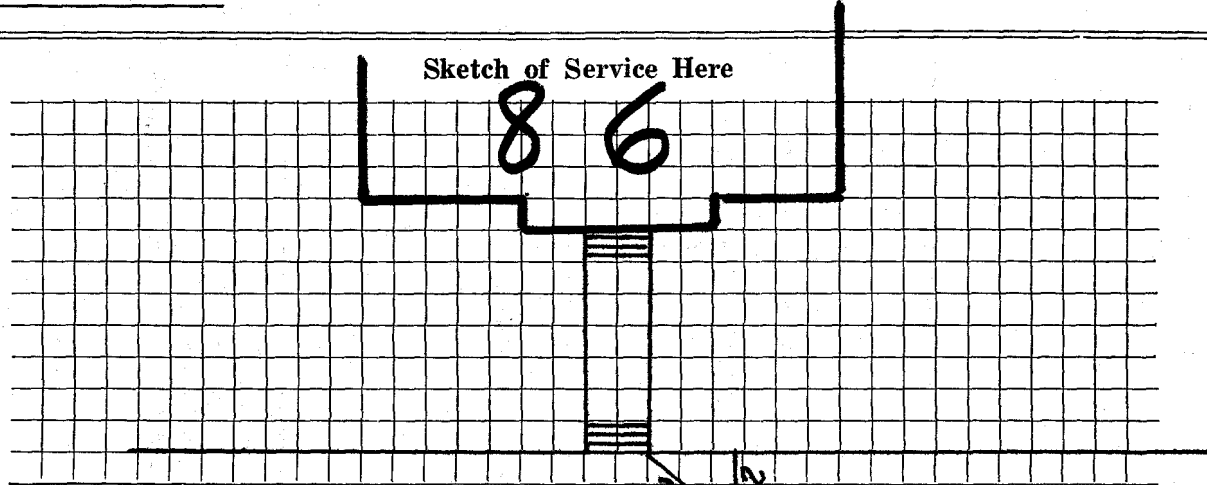

Connection made in _____

Street.

Work completed _____

19

Remarks:

