

Name Mr. Henry Brask, c/o Mr. C. A. Estey

1169
Service No. ~~52~~ 2382

Address ~~52 Grand View Rd., Arlington~~

9 Robbins Rd

Location

#9 Robbins Rd
Lot #20, Robbins Rd.

Kind of Pipe

Size

Size of Main

~~Repair & Renewal~~ - New Service

Location

Date	Material	Amount	Total	Date	Amount
Comm. 31.50	42' 1" C.L. Pipe @.27	11 34			
10-27-31	2 1" L.L. Coup. @.25	50			
	2 1" L.L. El. @.30	60			
	2 1" Br. Sp. Nip. @.25	50			
	1 S & W	3 00			
	Trucking	75	16 69		
9/2/31	7 Hrs. Labor @.55	3 85			
	3 " " @.60	1 80	5 65		
	15% Overhead		85		
	COST		23 19		
	Labor				
CHARGE	42 ft. @ .75	\$31 50	\$31 50		

Aug. 28 1931 - Cash
Checked 9-11-91 Outside
3/4 Copper

Hadley Press, Inc., Lexington

TOWN OF LEXINGTON—BOARD OF PUBLIC WORKS

WATER DIVISION

The undersigned applies for a supply of water at No. ^{Lot} 20 Robbins Road St. and hereby agrees to comply with the rules and regulations as now, or at any future time, established by the Board of Selectmen.

Am't. of Estimate \$ _____

Owner

Henry Bress


Am't. Paid \$ 90 - for water & sewer

Address

60 Ellistey
52 Grandview Rd
Lexington, Mass

Builder _____

Sketch of Service Here

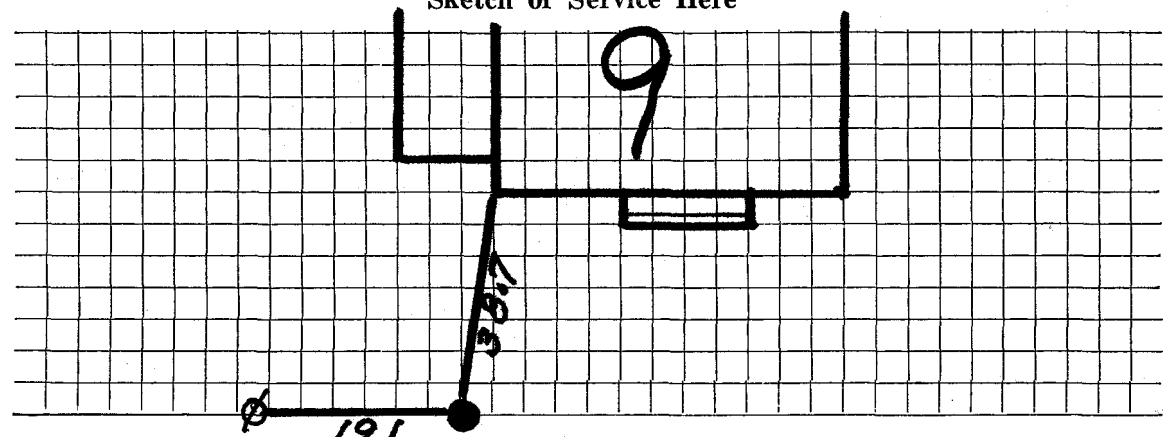

Connection made in 19-1 Street.

Work completed _____ 19

Remarks: