

WATER SERVICE RECORD

Name Willis R. Anderson

Service No. 107 #5293

Address 10 Robinson Road

Location Lexington

Repair, Renewal—New Service

Com. 7-28-52


Date	Material	Amount	Total	Date	Amount	
6/10/52	Labor	4 65		6-6-52	60 00	
	10% Overhead	47	5 12	7-28-52	5 22	
	55' - 3/4" Copper tubing @ .3439	18 91		Deposited NON CHARGE 54 78		
	1 - 3/4" C x 1/2 I.W.H. stop & waste	4 00		6/10/52	Labor	6 95
	3 hrs. Littlefield shovel	21 00		12' - 3/4" Copper tubing @ .3439		4 12
	1 hr. trucking		75	1 - 3/4" C. Corp-Cock		4 33
	patching 5 x 3		5 00	1 - 3/4" C x 3/4" C. Curb-cock		4 67
			54 78	1 box and rod		4 52
				1 - 1/2 offset tail piece		50
				1 - 1/2 straight tail piece		50
				1 hr. Littlefield Shovel		7 00
				1 hr. trucking		75
						33 34

DATE _____

TOWN OF LEXINGTON — BOARD OF PUBLIC WORKS

WATER DIVISION

Sketch of Service Here

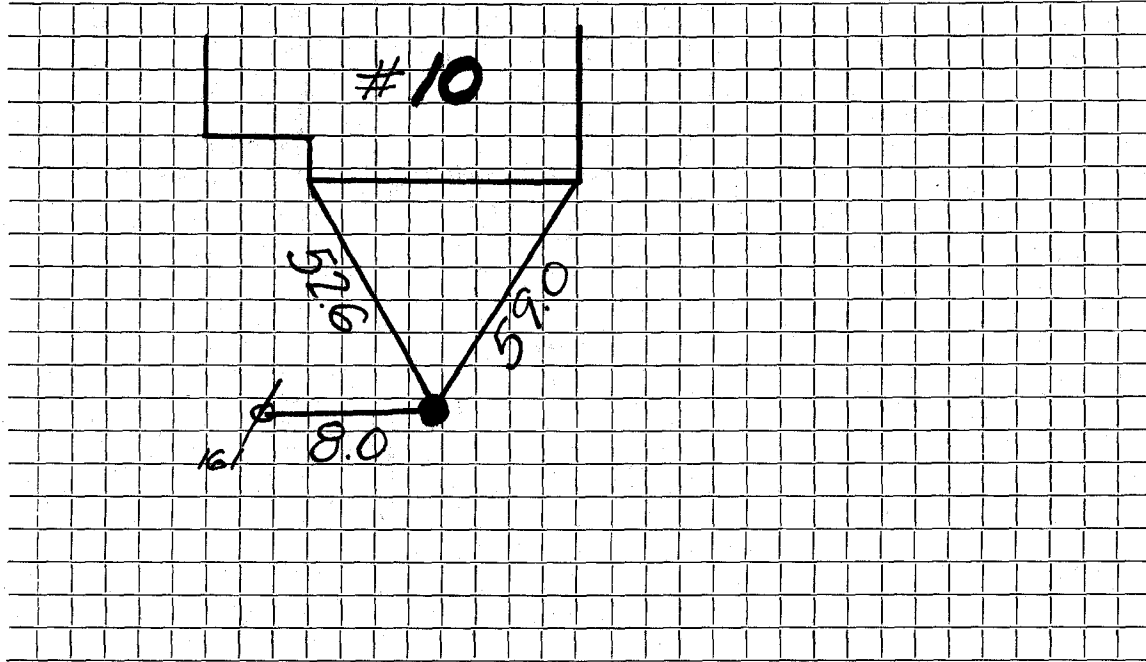

Connection made in Street. Work completed

Remarks:

.....

.....