

WATER SERVICE RECORD

Name Leo Zanghi

Service No. 263

Address 14 Robinson Road

#703

Location Lexington


~~Repair Renewal~~ — New Service

COM. 2-4-52

Date	Material	Amount	Total	Date	Amount
1/19/52	Labor	2 98	2 98	10-23-51	Deposited 70 00
	10% overhead		30	2-4-52	Refunded (13 78)
	50' - 3/4" copper tubing @ .3439		17 19		NON CHARGE 56 22
	1 - 3/4" C x 1/2 I.W.H. stop & waste	4 00		1/19/52 Labor	2 98
	3 hrs. Littlefield shovel	21 00		20' - 3/4" copper tubing @ .3439	6 88
	1 hr. trucking	75		1 - 3/4" C. corp-cock	4 33
	patching 10 x 3	10 00		1 - 3/4" Cx3/4" C. curb-cock	4 67
		56 22		1 - box and rod	4 52
				1 - 1/2 offset tail piece	50
				1 - 1/2 straight tail piece	50
				2 hrs. Littlefield shovel	14 00
				1 hr. trucking	75
					39 13

TOWN OF LEXINGTON — BOARD OF PUBLIC WORKS  
WATER DIVISION

Sketch of Service Here

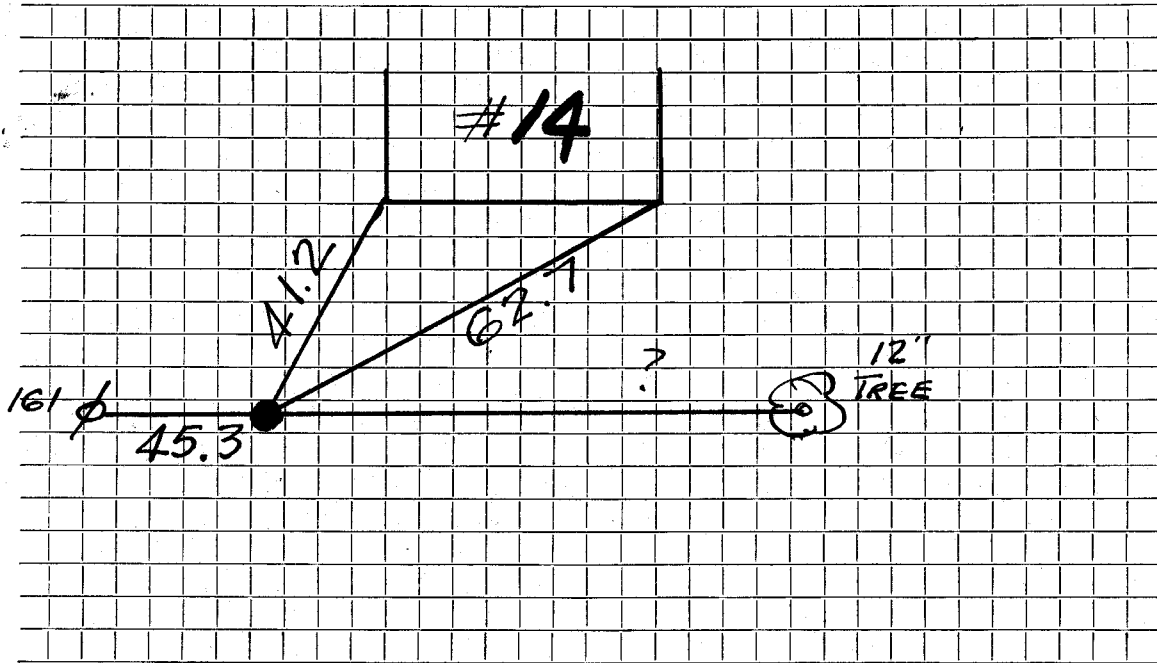

Connection made in ..... Street. Work completed .....

Remarks: .....

.....

.....