

Name Puritan Homes Inc.

Service No.

#5023
108#5024
3271

Address 15 Robinson Road

Lexington

Location

15 Robinson Road

Kind of Pipe

Size

Size of Main

~~Repair - General~~ New Service

Com. 7-3-50

Location

Date	Material	Amount	Total	Date	Material	Amount
June 19 '50	Labor	4 90	4 90	May 21 '50	Deposited	55 00
	10% Overhead	49	49	July 20 '50	Returned	7 68
	43' - 3/4" Copper Tubing @ 23¢	9 89	9 89		<u>No Charge</u>	47 32
	1 - 3/4"C x 1/2" I.W.H. S&W	3 29	3 29	June 19 '50	Labor	7 35
	2 hrs. Littlefield Shovel	14 00	14 00		20' 3/4" Copper Tubing @ 23¢	4 60
	1 hr. Trucking	75	75		1 - 3/4"C. Corp-cock	3 15
	Patching 14 x 3	14 00	14 00		1 - 3/4"C x 3/4"C Curb-cock	3 85
			47 32		1 Box & Rod	3 35
					1 - 1/2" Offset Tail Piece	38
					1 - 1/2" Straight Tail Piece	38
					1 hr. Littlefield Shovel	7 00
					1 hr. Trucking	75
	Labor					38 81

Hadley Press, Inc., Lexington

DATE _____

TOWN OF LEXINGTON—BOARD OF PUBLIC WORKS

WATER DIVISION

The undersigned applies for a supply of water at No. _____ St. and hereby agrees to comply with the rules and regulations as now, or at any future time, established by the Board of Selectmen.

Am't. of Estimate \$ _____


Owner _____

Am't. Paid \$ _____

Address _____

Builder _____

Sketch of Service Here

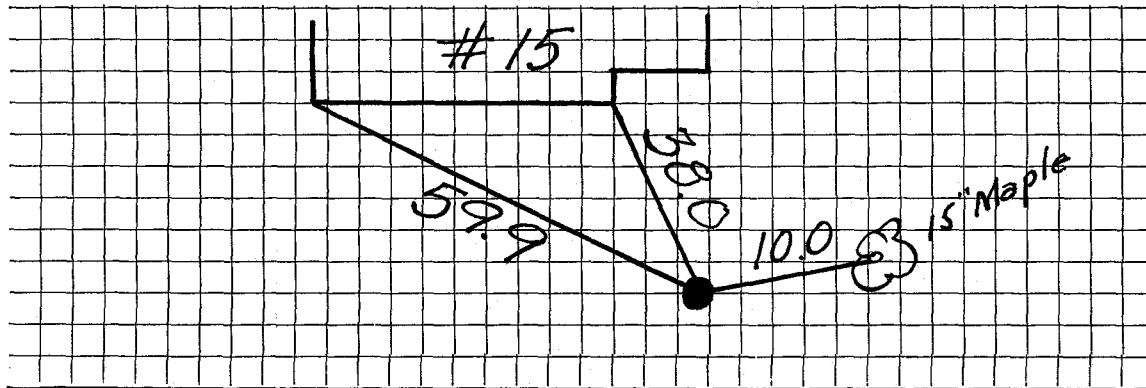

Connection made in _____ Street.

Work completed _____ 19

Remarks: