

Name Ernest Wortman

Service No.

284

Address 18 Robinson Road

#4076

Lexington, Mass.

Location 18 Robinson Road

Kind of Pipe

Size

Size of Main

~~Repair~~ ~~Renewal~~ New Service

Location

Date	Material	Amount	Total	Date	Amount	
Dec. 10, '48	Labor	5 35	5 35	Dec. 11 '48	65 00	
	10% Overhead		54	Dec. 31 '48	4 01	
	70' - 3/4" Copper Tubing @	255 17 85			60 96	
	1 - 3/4" C x 1/2" I.W.H. S&W		3 15	Dec. 10, '48	Labor	1 15
	1 - 3/4" C x 3/4" C Union		1 32		9' - 3/4" Copper Tubing @.255	2 30
	Littlefield Shovel 4 hrs. @7.00	28 00			1 - 3/4" C Corp-cock	3 00
	Trucking 1 hr. @.75		75		1 - 3/4" C x 3/4" C Curb-cock	3 68
	Patching 4 x 3		4 00		Littlefield Shovel 1 hr. @7.00	7 00
			60 96		1 - 1/2" Offset Tail Piece	30
					1 - 1/2" Straight Tail Piece	30
					Trucking 1 hr. @.75	75
					1 - Box & Rod	3 55
	Labor					22 03

TOWN OF LEXINGTON - BOARD OF PUBLIC WORKS

WATER DIVISION

The undersigned applies for a supply of water at No..... St. and hereby agrees to comply with the rules and regulations as now, or at any future time, established by the Board of Selectmen.

Am't of Estimate \$.....

Owner


Am't Paid \$.....

Address

Builder

.....

Sketch of Service Here

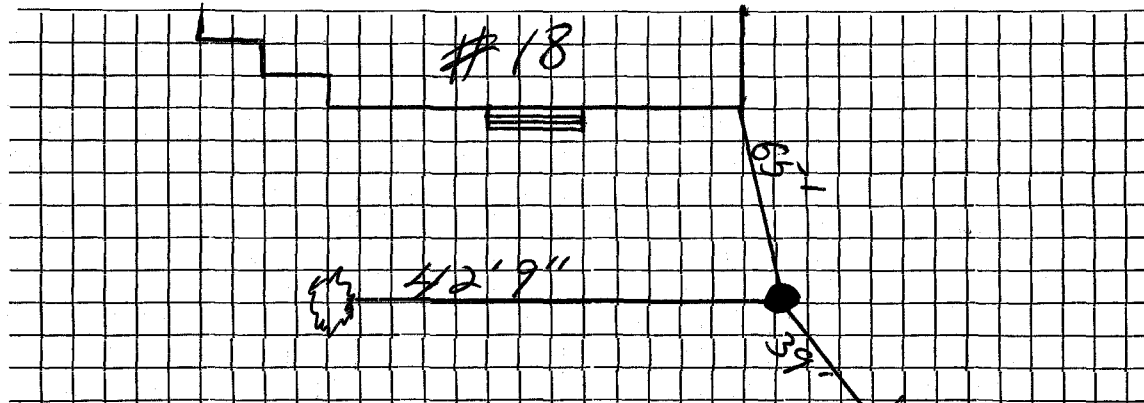

Connection made in Street.

Work completed19

Remarks: