

Name Puritan Homes Inc.

Service No. 108

Address 19 Robinson Road

#7747

Lexington

Location 19 Robinson Road

Kind of Pipe

Size

Size of Main

~~Repair-Renewal~~—New Service

Com. 7-3-50

Location

Date

Material

Amount

Total

Date

Amount

June 17 '50

Labor

4 90

4 90

May 24 '50

Deposited

55 00

10% Overhead

49

49

July 20 '50

Refunded

7 06

37' - 3/4" Copper Tubing @ 23¢

8 51

45 94

1 - 3/4"C x 1/2" I.W.H. S&W

3 29

No Charge

2 hrs. Littlefield Shovel

14 00

June 17 '50 Labor

19 55

1 hr. Trucking

75

18' - 3/4" Copper Tubing @ 23¢

4 14

Patching 14 x 3

14 00

1 - 3/4"C. Corp-cock

3 15

45 94

1 - 3/4"C x 3/4"C Curb-cock

3 85

1 Box & Rod

3 35

1 - 1/2" Offset Tail Piece

38

1 - 1/2" Straight Tail Piece

38

1 hr. Littlefield Shovel

7 00

1 hr. Trucking

75

Labor

42 55

TOWN OF LEXINGTON—BOARD OF PUBLIC WORKS

WATER DIVISION

The undersigned applies for a supply of water at No. _____ St. and hereby agrees to comply with the rules and regulations as now, or at any future time, established by the Board of Selectmen.

Am't. of Estimate \$ _____


Owner _____

Am't. Paid \$ _____

Address _____

Builder _____

Sketch of Service Here

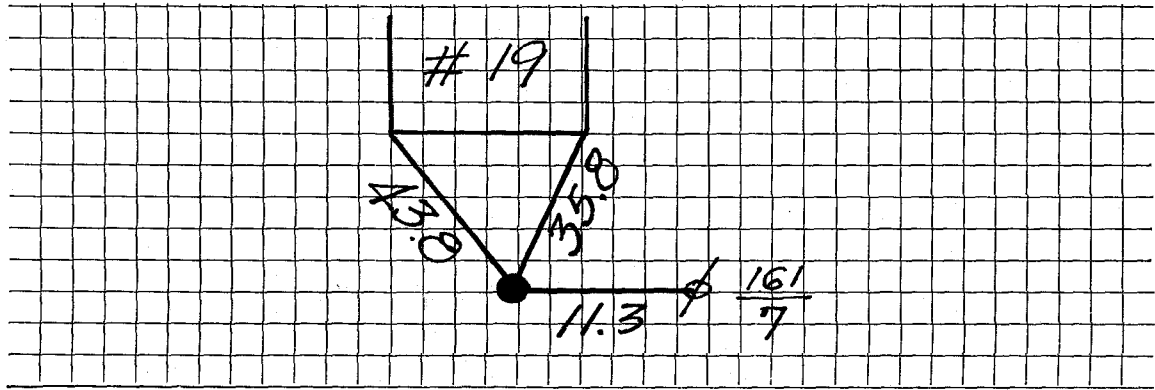

Connection made in _____ Street.

Work completed _____ 19

Remarks: