

Name Norman Woodward

Service No.

186

3381

Address 20 Robinson Road

#3662

Location 20 Robinson Road

Kind of Pipe

Size

Size of Main

~~MADE BY WORK~~ New Service

Com 12-1-47

Location

Date	Material	Amount	Total	Date	Amount
Oct. 6, '47	Labor	7 80	7 80	Oct 6 47	Deposited 65 00
	10% Overhead		78	Dec 4 47	Expended 30 92
	60' - 3/4" Copper Tubing @ .26	15 60			Non-Charge 34 08
	1 - 3/4" C x 1/2" I.W.H. S & W	3 15		Oct. 6, '47	Labor 1 10
	Shovel 1 hr. @ 3.00	3 00			16' - 3/4" Copper Tubing @ .26 4 16
	D 4 Tractor 1 hr. @ 3.00	3 00			1 - 3/4" C Corp-cock 3 00
	Trucking 1 hr. @ .75	75			1 - 3/4" C x 3/4" C Curb-cock 3 68
			34 08		1 - 1/2" Straight Tail Piece 30
					1 - 1/2" Offset Tail Piece 30
					Trucking 1 hr. @ .75 75
					<u>13 29</u>
	Labor				

DATE \_\_\_\_\_

# TOWN OF LEXINGTON - BOARD OF PUBLIC WORKS

## WATER DIVISION

The undersigned applies for a supply of water at No..... St. and hereby agrees to comply with the rules and regulations as now, or at any future time, established by the Board of Selectmen.

Am't of Estimate \$.....

Owner .....


Am't Paid \$.....

Address .....

Builder .....

*19 Duke St. Lex.*

Sketch of Service Here

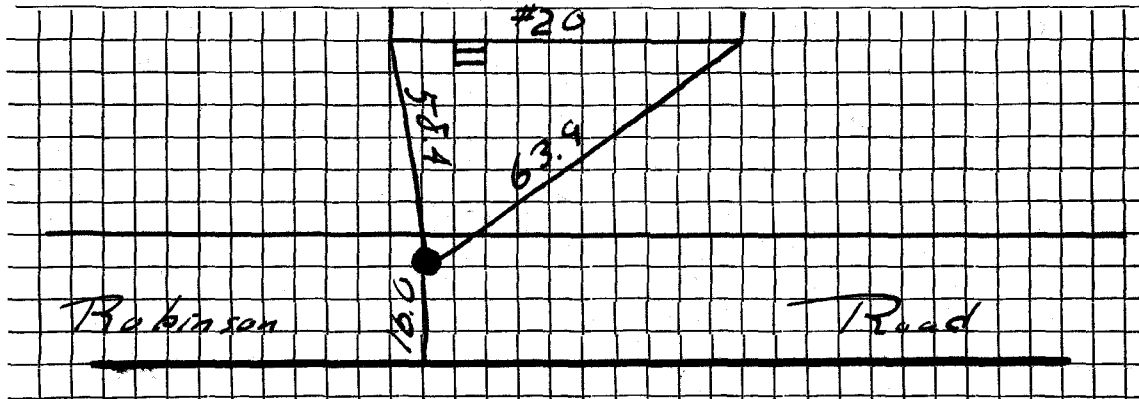

Connection made in ..... Street.

Work completed .....19

Remarks: