


DATE AUGUST 1996

TOWN OF LEXINGTON — BOARD OF PUBLIC WORKS

WATER DIVISION

Sketch of Service Here

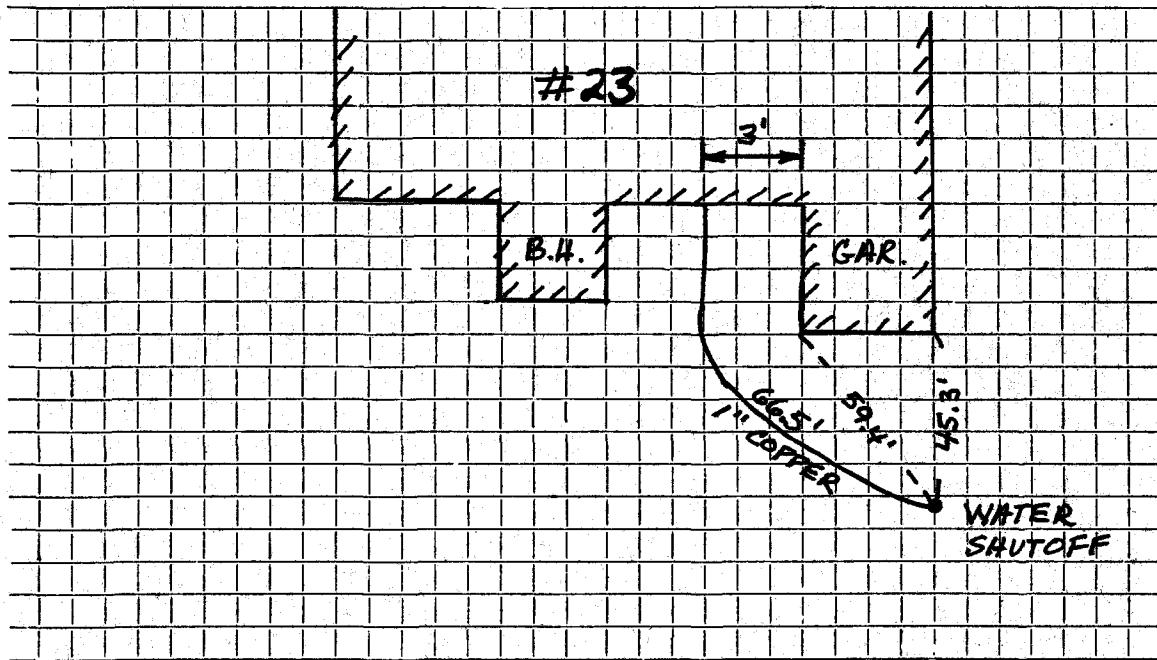

Connection made in ~~23~~ ROBINSON ROAD Street.

Work completed G.W. GATELY

Remarks: