

Name ~~Winthrop~~ **Woodward**

Service No. 175

3415

Address 24 Robinson Road

2731

Location 24 Robinson Road

Kind of Pipe

Size

Size of Main

REPAIRS—New Service

Corn 12/3, 147

Location

| Date | Material | Amount | Total | Date | Amount |
|-------------|----------------------------------|--------|-------|--------------------------------|------------|
| Oct. 6, '47 | Labor | 7 80 | 7 80 | Mar 16 '48 | Paid 35 92 |
| | 10% Overhead | | 78 | | |
| | 62' - 3/4" Copper Tubing @ .26 | 16 12 | | | Non-Charge |
| | 1 - 3/4" c x 1/2" I.W.H. S & W | 3 15 | | Oct. 6, '47 | Labor 1 10 |
| | 1 - 3/4" C x 3/4" C Union 5 pts. | 1 32 | | 14' - 3/4" Copper Tubing @ .26 | 3 64 |
| | Shovel 1 hr. @ 3.00 | 3 00 | | 1 - 3/4" C Corp-cock | 3 00 |
| | D 4 Tractor 1 hr. @ 3.00 | 3 00 | | 1 - 3/4" C x 3/4" C Curb-cock | 3 68 |
| | Trucking 1 hr. @ .75 | | 75 | 1 - Box & Rod | 4 26 |
| | | | 35 92 | 1 - 1/2" Offset Tail Piece | 30 |
| | | | | 1 - 1/2" Straight Tail Piece | 30 |
| | | | | Trucking 1 hr. @ .75 | 75 |
| | | | | | 17 03 |
| | Labor | | | | |

Bell sent 1/8/48

TOWN OF LEXINGTON – BOARD OF PUBLIC WORKS

WATER DIVISION

The undersigned applies for a supply of water at No..... St. and hereby agrees to comply with the rules and regulations as now, or at any future time, established by the Board of Selectmen.

Am't of Estimate \$.....

Owner


Am't Paid \$.....

Address

Builder

.....

Sketch of Service Here

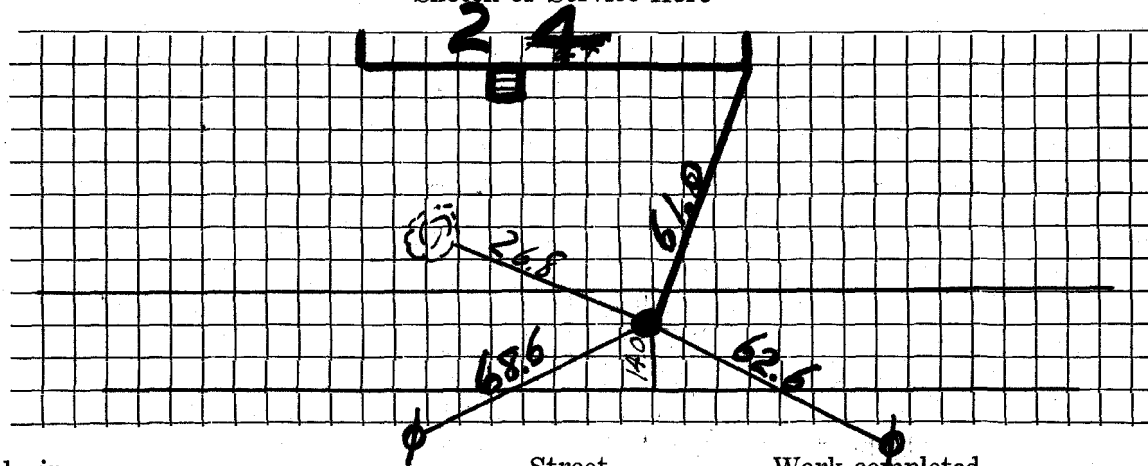

Connection made in Street.

Work completed19

Remarks: