

WATER SERVICE RECORD

Name Charles W. Mallett

Service No. 363

Address 25 Robinson Road

Location Lexington, Mass.

~~Reconnect~~ - New Service

Com. 5-21-51


Date	Material	Amount	Total	Date	Amount
2/23/51	Labor	14 00	14 00	<i>Dec 2 1950</i>	<i>Deposited</i>
	10% overhead	1 40	1 40		
	195' 1" copper tubing @ .43	83 85	83 85		
	1 - 1" Cx3/4" I.W.H. S&W	5 12	5 12	2/23/51 - labor No Charge	
	4-1" Cx1" c.Unions @ 1.83	7 32	7 32	27' - 2 1/2" copper tubing @ .43	
	3 hrs. littlefield shovel @ 7.	21 00	21 00	1 - 1" C.corb-cock	
	2 hrs. Allis-Chalmers @ 3.00	6 00	6 00	1 - 1" C x 1" C.curb-cock	
	trucking 1 hr.		75	1 - Box and rod	
			139 44	1 - 3/4" offset tail piece	
				1 - 3/4" straight tail piece	
				1 hr. Littlefield shovel	
				1 hr. Allie chalmers	
				1 hr. trucking	
					59 99

DATE _____

TOWN OF LEXINGTON — BOARD OF PUBLIC WORKS

WATER DIVISION

Sketch of Service Here

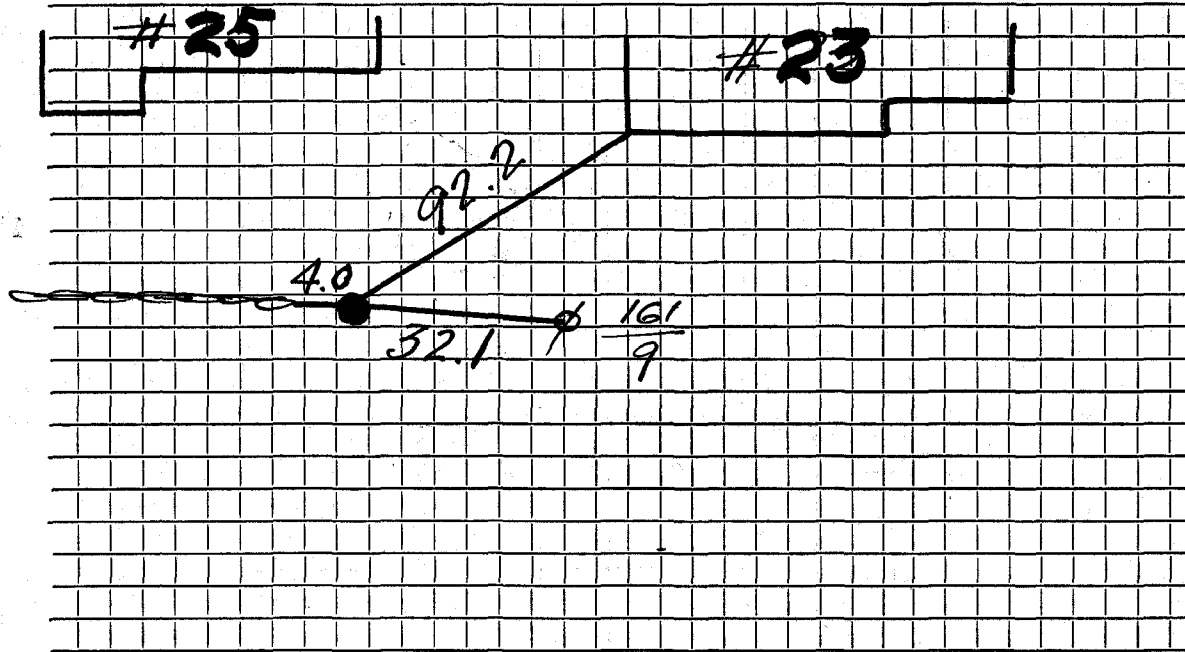

Connection made in Street. Work completed

Remarks:
.....
.....