

Name **Endel Reinap**

Service No.

138

8383

Address **28 Robinson Road**Location **28 Robinson Road**

5239

6510

Kind of Pipe

Size

Size of Main

~~Repair-Renewal~~ - New Service

Cm 12-1-47

Location

Date	Material	Amount	Total	Date		Amount
Oct. 7, '47	Labor	11 65	11 65	Oct 6 '47	Deposited	100 00
	10% Overhead		1 17	Dec 4 '47	Refunded	<u>47 34</u>
	87' - 3/4" Copper Tubing @.26	22 62			Non-Charge	52 66
	1 - 3/4" C x 1/2" I.W.H. S & W	3 15		Oct. 7, '46	Labor	1 10
	1 - 3/4" C x 3/4" C U. 3 pts.	1 32		26' - 3/4" Copper Tubing @.26		6 76
	Gas Shovel 2 hrs. @ 3.00	6 00		1 - 3/4" C Corp-cock		3 00
	D & Tractor 2 hrs. @ 3.00	6 00		1 - 3/4" C x 3.4" C Curb-cock		3 68
	Trucking 1 hr. @ .75		75	1 - Box & Rod		4 26
			52 66	2 - 1/2" Straight Tail Pieces		60
				Trucking 1 hr. @.75		<u>75</u>
						20 15
	Labor					

TOWN OF LEXINGTON - BOARD OF PUBLIC WORKS

WATER DIVISION

The undersigned applies for a supply of water at No..... St. and hereby agrees to comply with the rules and regulations as now, or at any future time, established by the Board of Selectmen.

Am't of Estimate \$.....

Owner


Am't Paid \$.....

Address

Builder

1099 Main Avenue - Lex

Sketch of Service Here

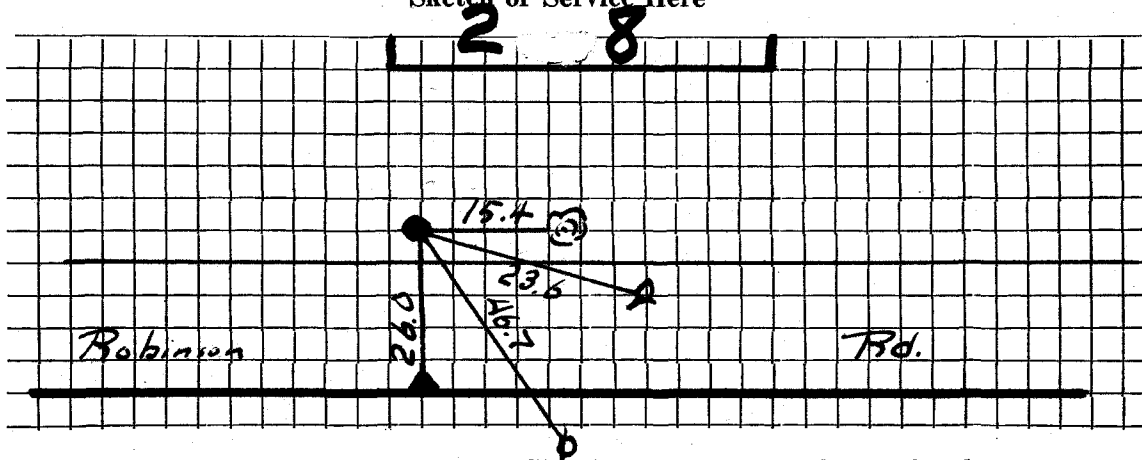

Connection made in

Street.

Work completed19

Remarks: