


DATE 4/15

TOWN OF LEXINGTON — BOARD OF PUBLIC WORKS

WATER DIVISION

Sketch of Service Here

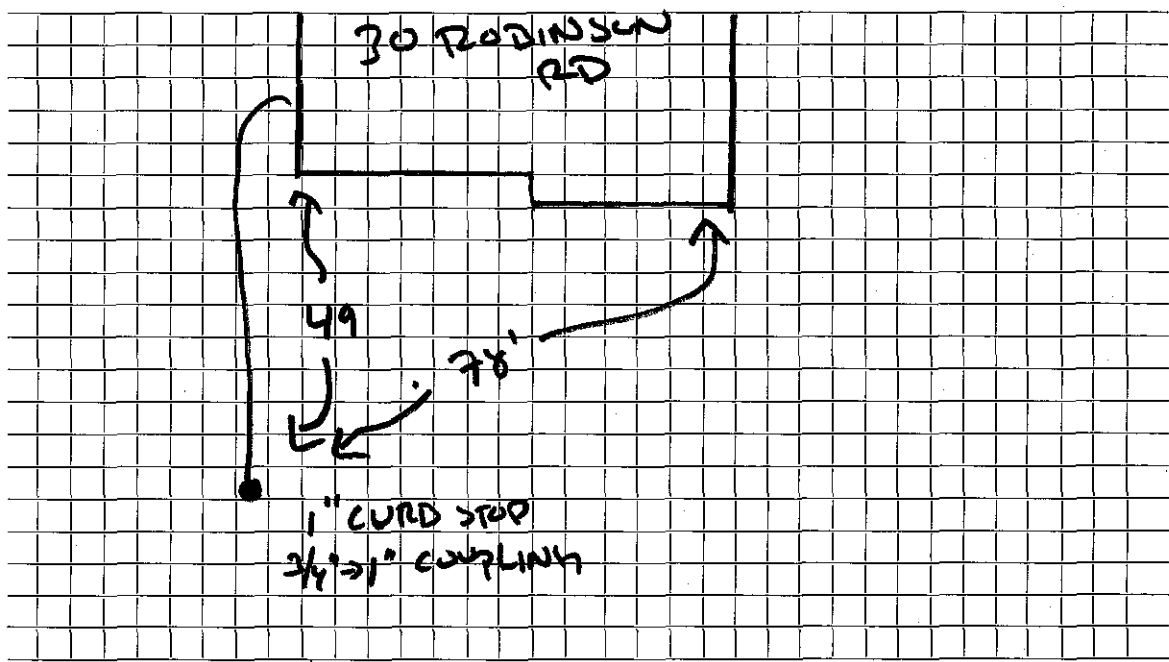

Connection made in ROBINSON RD Street. Work completed ~~DAVID STOUT~~ B.K.C.

Remarks:

.....

.....