

WATER SERVICE RECORD

Name Henry Schechter

Service No. 294

Address 34 Robinson Road

3900

Location Lexington, Mass.

~~Repair or Renewal~~ - New Service

Com. 12-31-50

Date	Material	Amount	Total	Date	Amount
Sept. 20, '50	Labor	2 70	2 70	Sept. 11 '50	Deposited 35 00
	10% Overhead		27	Jan 19 '51	Paid 15 45
	130' - 3/4" Copper Tubing @	275 35	75		No Charge 50 45
	1 - 3/4"C x 1/2" I.W.H. S&W		3 76	Sept. 20, '50	Labor 4 20
	2 - 3/4"C x 3/4"C Unions		3 22	10' - 3/4" Copper Tubing @.275	2 75
	Trucking 1 hr. @.75		75	1 - 3/4" C Corp-cock	3 60
	Patching 4 x 3		4 00	1 - 3/4"C x 3/4"C Curb-cock	4 40
			50 45	1 - Box & Rod	3 35
				1 - 1/2" Offset Tail Piece	42
				1 - 1/2" Straight Tail Piece	42
				Littlefield Shovel 3 hrs. @7.00	21 00
				Trucking 1 hr. @.75	75
					40 89


Bills sent 1-12-51

DATE _____

TOWN OF LEXINGTON — BOARD OF PUBLIC WORKS

WATER DIVISION

Sketch of Service Here

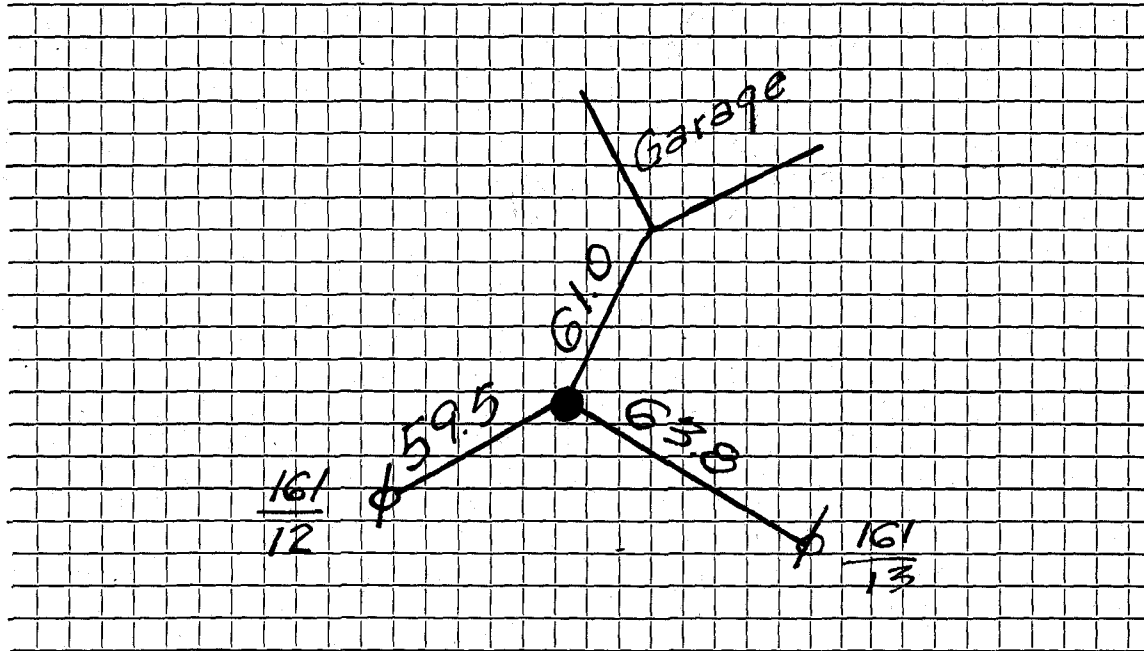

Connection made in Street. Work completed

Remarks:
.....
.....