




DATE \_\_\_\_\_

**TOWN OF LEXINGTON — BOARD OF PUBLIC WORKS**  
**WATER DIVISION**

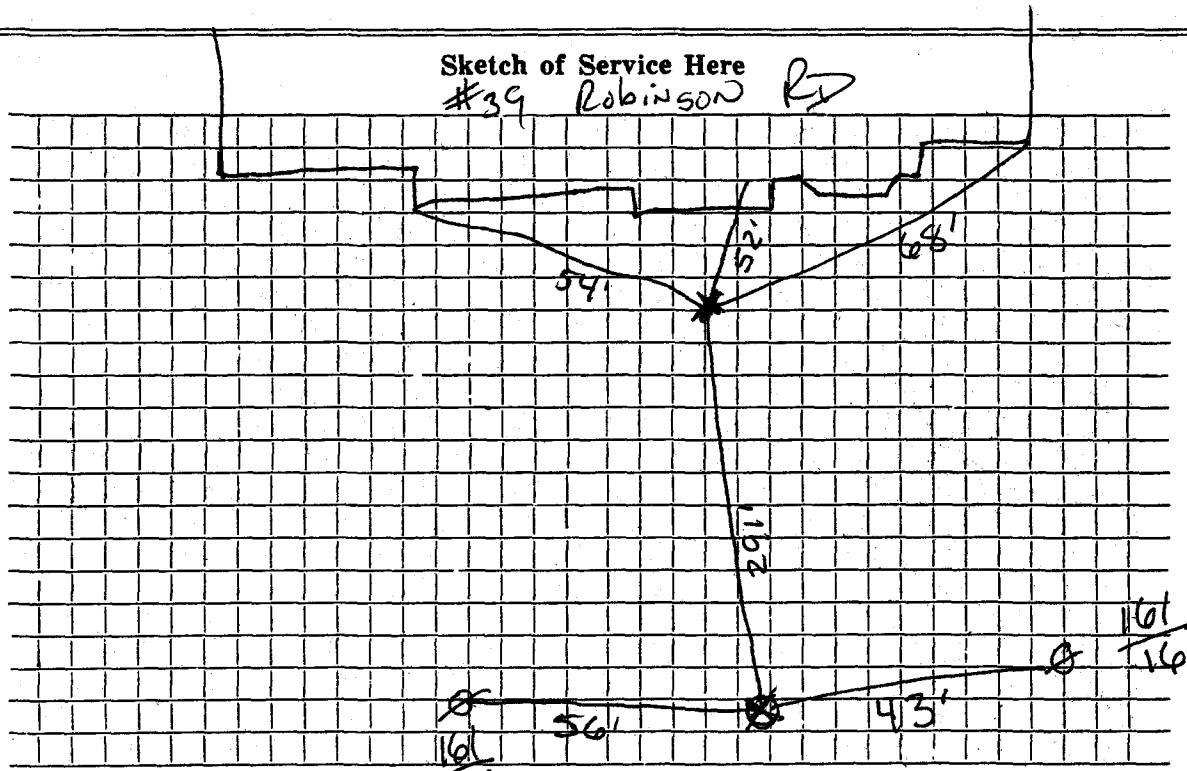

Connection made in ..... Street. Work completed .....

Remarks: .....  
Tear down - Old 1" service cut. 52' of 1" Copper put into  
new house. Pit meter removed at street