


DATE APRIL 24 1998

TOWN OF LEXINGTON — BOARD OF PUBLIC WORKS
WATER DIVISION

Sketch of Service Here

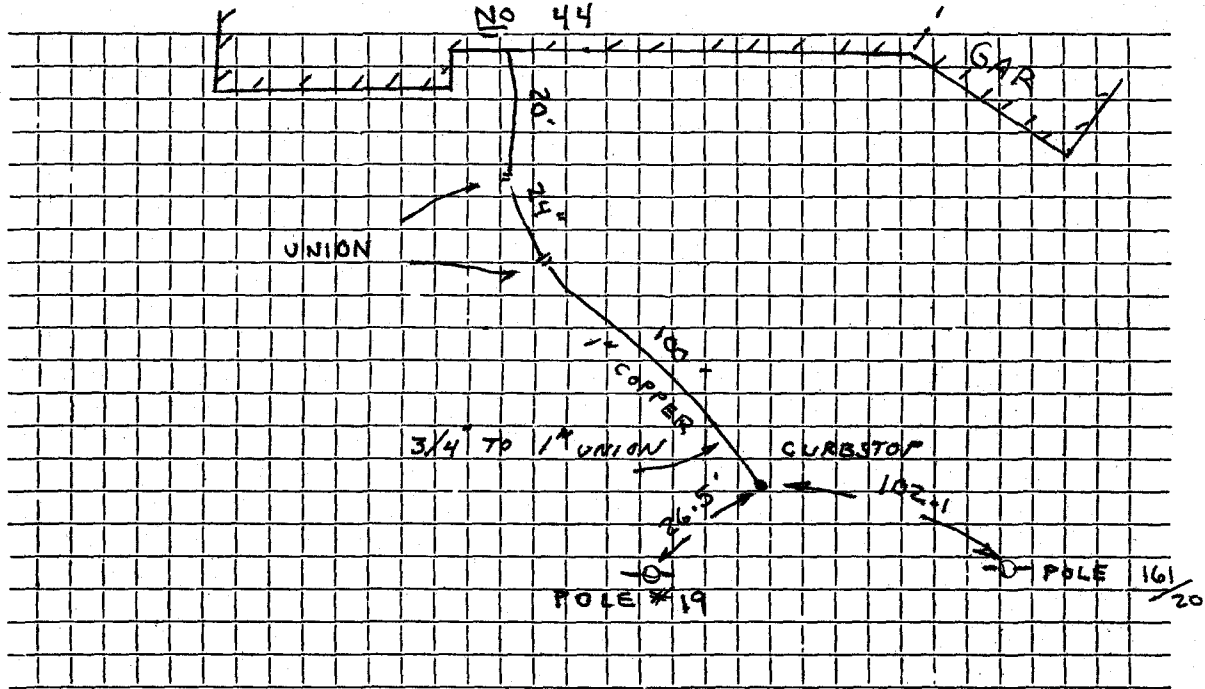

Connection made in ROBINSON ST. Street. Work completed by J. M. McLAUGHLIN

Remarks:
FIELD BOOK 98-1 TJM

Name **George Andrews**

Service No. **178** *3/18*

Address **44 Robinson Road N044**

Location **44 Robinson Road**

Kind of Pipe ~~8" x 12" Cast Iron~~ Size **4"** Size of Main **4"**

Service ~~Renewal~~ **New Service** Location **Corr 12/31/47**

Date	Material	Amount	Total	Date	Amount
Oct. 10, '47	Labor	4 40	4 40	Dec 9 '47 Paid	38 36
	10% Overhead		44		
	55' - 3/4" Copper Tubing @ .26	14 30			Non-Charge
	1 - 3/4" C x 1/2" I.W./H. S & W.	3 15		Oct. 10, '47 Labor	7 00
	1 - 3/4" C x 3/4" C Union 3 pts	1 32		21' - 3/4" Copper Tubing @ .26	5 46
	Hired Shovel 2 hrs. @ 7.00	14 00		1 - 3/4" C Corp-cock	3 00
	Trucking 1 hr. @ .75		75	1 - 3/4" C x 3/4" C Curb-cock	3 68
			<u>38 36</u>	1 - Box & Rod	4 26
				1 - 1/2" Offset Tail Piece	30
				1 - 1/2" Straight Tail Piece	30
				Trucking 1 hr. @ .75	75
					<u>24 75</u>
	Labor				

Bill Sent 1/8/48

DATE _____

TOWN OF LEXINGTON - BOARD OF PUBLIC WORKS

WATER DIVISION

The undersigned applies for a supply of water at No..... St. and hereby agrees to comply with the rules and regulations as now, or at any future time, established by the Board of Selectmen.

Am't of Estimate \$.....

Owner


Am't Paid \$.....

Address

Builder

.....

Sketch of Service Here

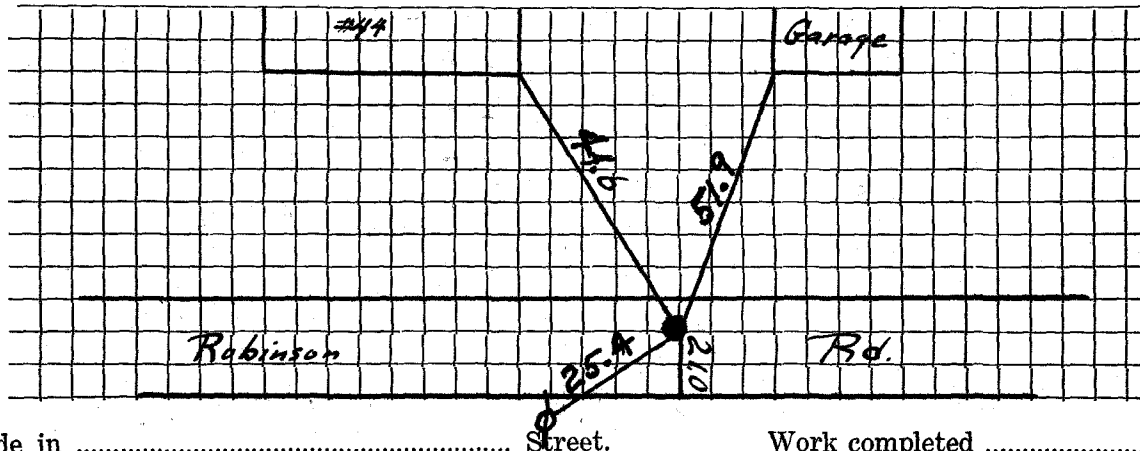

Connection made in Street.

Work completed19

Remarks: