

## WATER SERVICE RECORD

Name George Miller

Service No. 53

Address 46 Robinson Rd.

Location

~~Repair—Renewal—New Service~~ WO #4910 DeFlice Bros. #2871

MAY 9 1977


Date	Material	Amount	Total	Date	Amount
9/27/76	labor	63. 41		9-24-76	500.00
	10%OH	6. 34	69. 75	5-9-77	51.71
16	6" - 1" copper @ .83		13. 28		148.59
1	1" corp.		16. 69		
1	1" curb stop		18. 67		
1	curb box and fod		15. 40		
2	hr. shovel @ 6.50		13. 00		
½	hr. trucking @ 3.00		1. 50		
			148. 29		
10/4/76	120' 1" Copper				

DATE \_\_\_\_\_

TOWN OF LEXINGTON — BOARD OF PUBLIC WORKS

WATER DIVISION

Sketch of Service Here

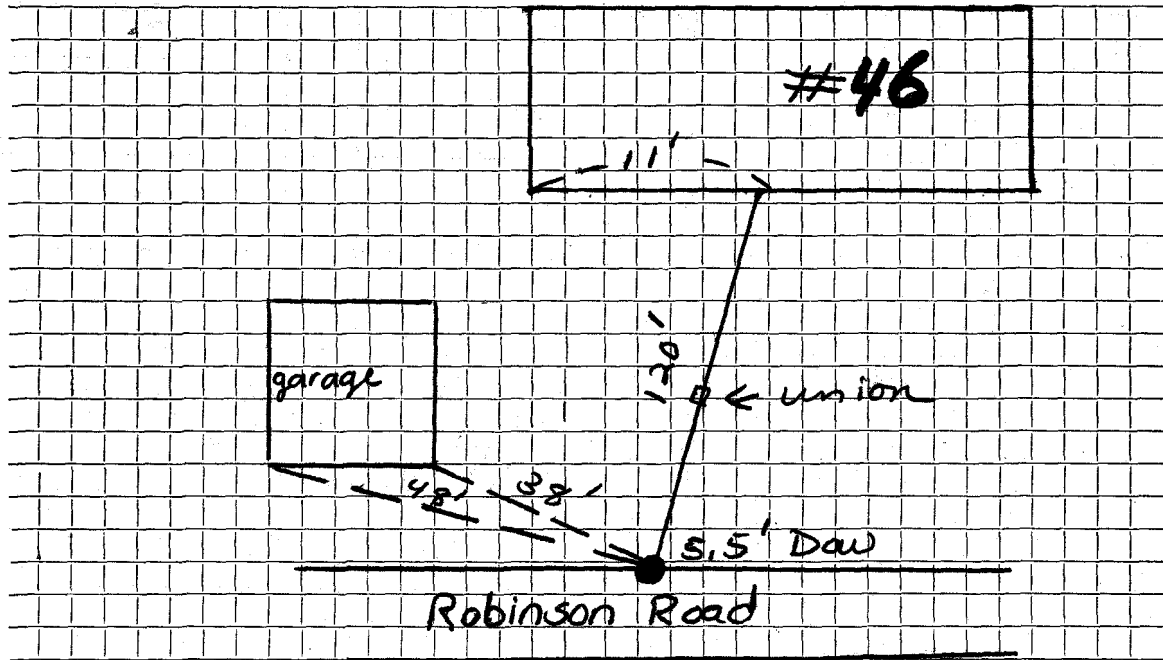

Connection made in ..... Street. Work completed .....

Remarks: .....

.....

.....