

Name **W. L. Morris**

Service No.

184
3379Address **47 Robinson Road**

#6133

Location **47 Robinson Road**

#6134

#7716

Kind of Pipe

Size

Size of Main

~~ROBINSON ROAD~~ - New Service

Cm 12.1.47

Location

Date	Material	Amount	Total	Date	Amount
Oct. 9 '47	Labor	12 65	12 65	Oct 4 '47	50 00
	10% Overhead		1 27	Dec 4 '47	5 92
	69' - 3.4" Copper Tubing @.26		17 94		44 08
	1 - 3/4" C x 1/2" I/W.H. S & W		3 15	Oct. 9, '47	13 30
	1 - 3/4" C x 3/4" C U. 3 pt.		1 32	11' - 3/4" Copper Tubing @.26	2 86
	Hired Shovel 1 hr. @ 7.00		7 00	1 - 3/4" C Corp-cock	3 00
	Trucking 1 hr. @.75		75	1 - 3/4" C x 3/4" C Curb-cock	3 68
			44 08	1 - Box & Rod	4 26
5-25-93	Repair			1 - 1/2" Offset Tail Piece	30
	3' - COPPER			1 - 1/2" Straight Tail Piece	30
	2 - UNIONS COMP.			Trucking 1 hr. @.75	75
	Labor				28 45

Deposited
 Deposited
 Non-Charge

TOWN OF LEXINGTON - BOARD OF PUBLIC WORKS
WATER DIVISION

The undersigned applies for a supply of water at No..... St. and hereby agrees to comply with the rules and regulations as now, or at any future time, established by the Board of Selectmen.

Am't of Estimate \$.....


Owner

Am't Paid \$.....

Address

Builder

.....

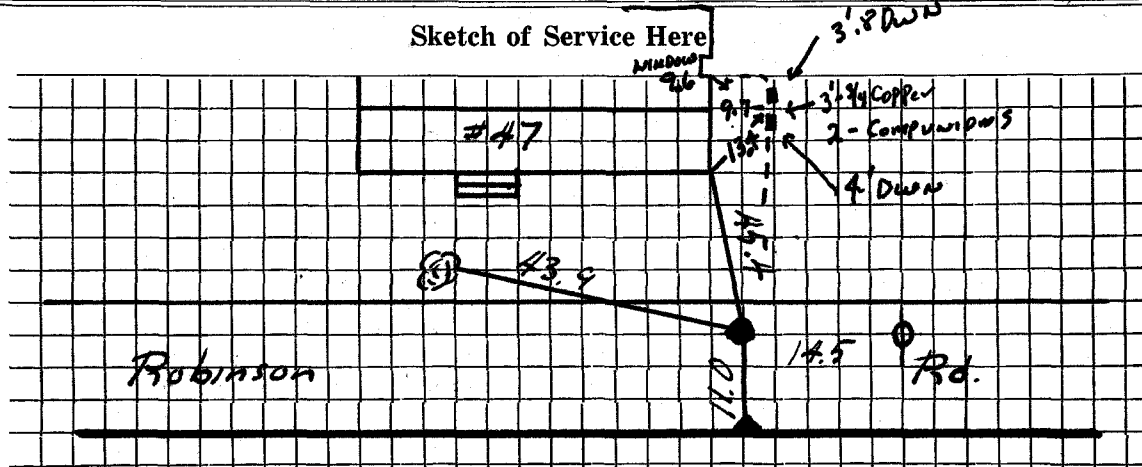

Connection made in Street.

Work completed19

Remarks: