

WATER SERVICE RECORD

3047

Name Albert Toler

Service No. 124

Address 51 Robinson Road

Location

~~EXPANDED~~ New Service Craftsman Inc. Permit #A-116 W.O. #1315


MAR 14 1966

Date	Material	Amount	Total	Date	Amount
11-23-65	Labor	25 91		11-19-65	100 00
	10% O.H.	<u>2 59</u>	28 50	3-11-66	23 23
		25 91			76 77
11'	3/4" copper tubing @ .70		7 70		
1	Curb		8 76		
1	Corp.		7 41		
	8 x 3 Patch		8 00		
1	Box & Rod		4 90		
1-1/3	Hrs Town Truck @ 3.00		4 00		
1	Hr. Shovel		6 50		
1-1/3	Hrs. Roller @ 3.00		1 00		
			<u>76 77</u>		
12-2-65	86' 3/4" copper tubing				

TOWN OF LEXINGTON — BOARD OF PUBLIC WORKS

WATER DIVISION

Sketch of Service Here

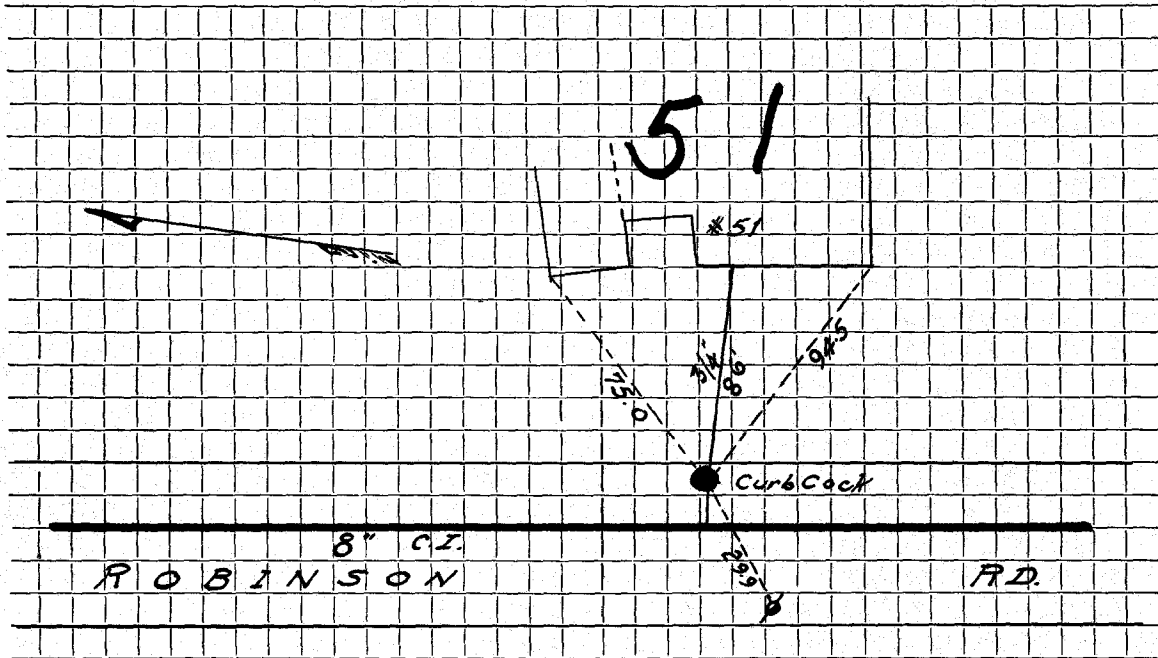

Connection made in Street. Work completed

Remarks:
.....
.....