


TOWN OF LEXINGTON — BOARD OF PUBLIC WORKS
WATER DIVISION

DATE 4/12/2021

Sketch of Service Here

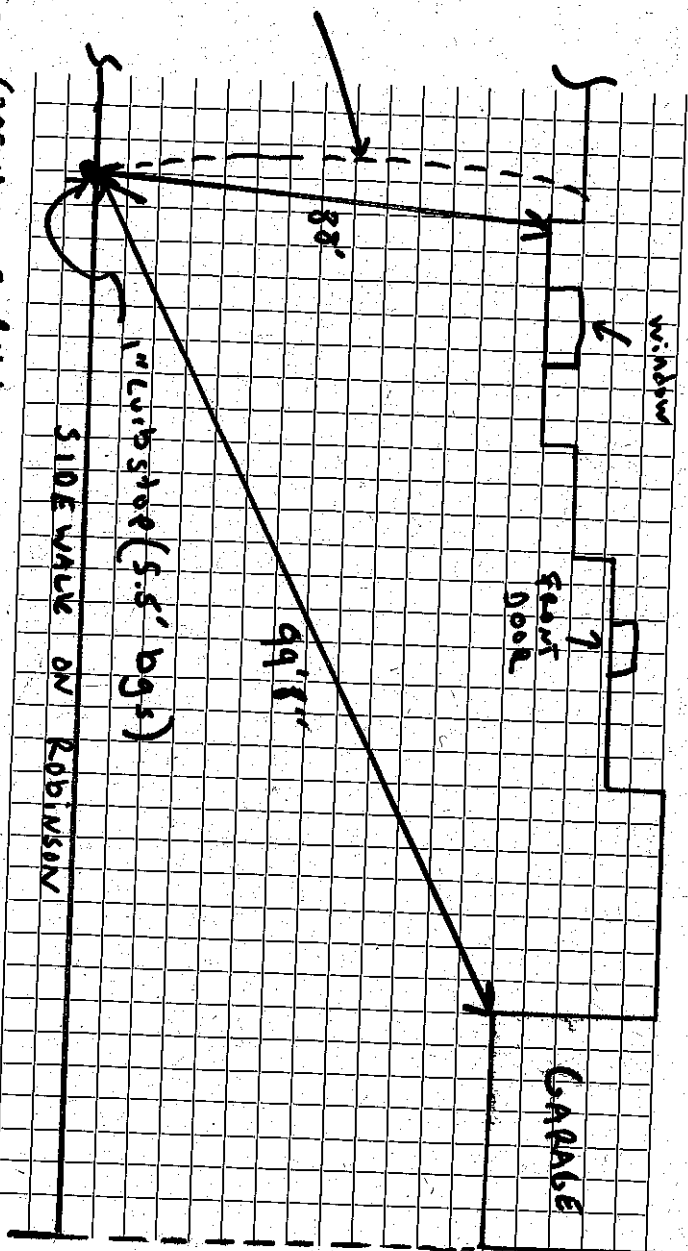

1" water line
 ~90°

Connection made in SIDEWALK OF ROBINSON Street.

Work completed 1" Reverdi

Remarks:

Drawn

WATER SERVICE RECORD

Name **Robert L. Higgins**

Service No. **9**

Address **54 Robinson Road**

2096

Location

~~Repair~~ **New Service** **WO #7068**

Com 5-28-62


Date	Material	Amount	Total	Date	Amount
3-26-62	Labor	36.47		3-19-62	Deposit 150.00
	10% O.H.	3.65	40.12	5-28-62	Refund 9.50
120'	3/4" Copper tubing @.42		50.40		140.00
1	3/4" x 1/2" I.W.H. Stop & Waste		6.17		NON CHARGE
1	3/4" C 3 part union		2.41	3-26-62	Labor 6.08
16	x 3 Patch		16.00	20'	3/4" Copper tubing @.42 8.40
3	hrs. Town Shovel @6.50		19.50	1	3/4" C Corp Cock 4.91
2	hrs. Trucking @3.00		6.00	1	3/4" C Curb Cock 6.28
			140.60	1	Box & Rod 4.90
				1	1/2 Straight tailpiece .50
				1	1/2 Offset tailpiece .50
				1	hr. Trucking @3.00 3.00
				1	hr. Town Shovel @6.50 6.50
					<u>41.97</u>

DATE _____

TOWN OF LEXINGTON — BOARD OF PUBLIC WORKS

WATER DIVISION

Sketch of Service Here

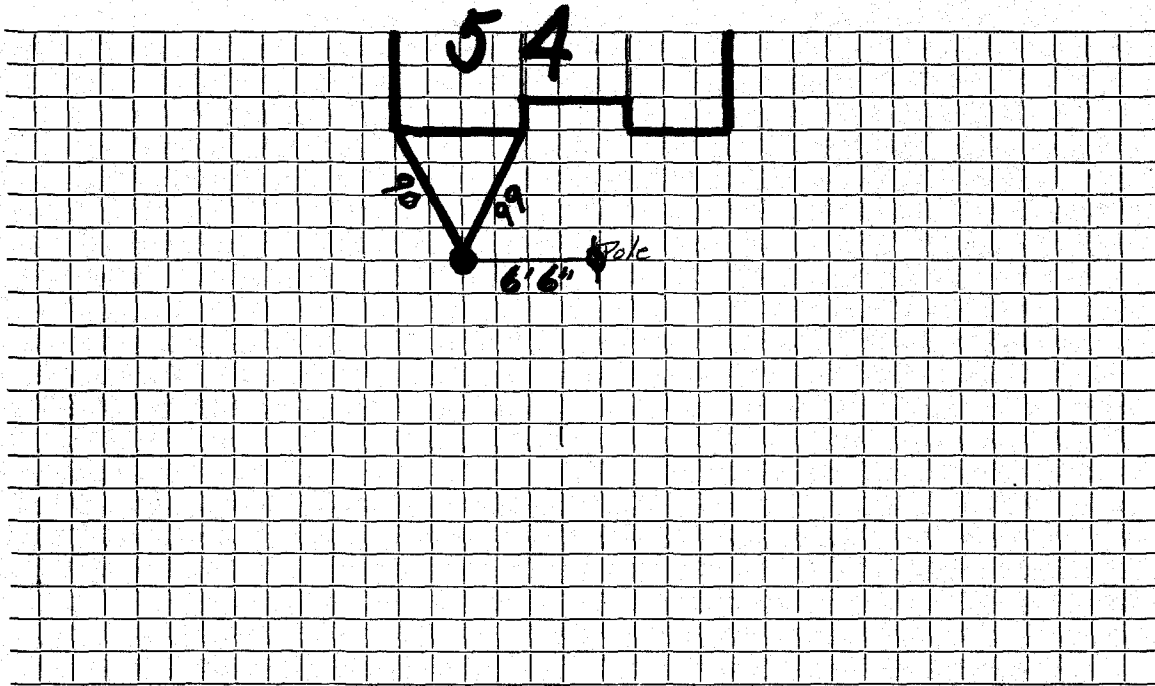

Connection made in Street. Work completed

Remarks:

.....

.....