

WATER SERVICE RECORD

2686

Name Willis R. Anderson

Service No. 113

Address 8 Robinson Rd.

Location Lexington

~~REPAIRS~~ - New Service


Am. 7-13-53

Date	Material	Amount	Total	Date	Amount
5/29/53	Labor	12 50		5-26-53 Deposited	75 00
	10% overhead	1 25	13 75	7-13-53 Refunded	(12 46
	42'-3/4" Copper Tubing @.37		15 54		NON CHARGE 62 54
	1-3/4" C x 1/2 I.W.H. STOP & WASTE		4 00	Labor 5/29/53	12 50
	3 Hr. Littlefield Shovel @7.50		22 50	12'-3/4" Copper Tubing @.37	4 44
	1 Hr. Trucking		75	1-3/4" C. Corp-cock	4 33
	Patching 6 x 3		6 00	1-3/4" C x 3/4" C. Curb-cock	4 67
			62 54	1-Box & Rod	3 90
				1-1/2 offset tail piece	50
				1-1/2 straight tail piece	50
				1 Hr. Littlefield shovel	7 50
				1 Hr. Trucking	75
					<u>39 09</u>

DATE _____

TOWN OF LEXINGTON — BOARD OF PUBLIC WORKS
WATER DIVISION

Sketch of Service Here

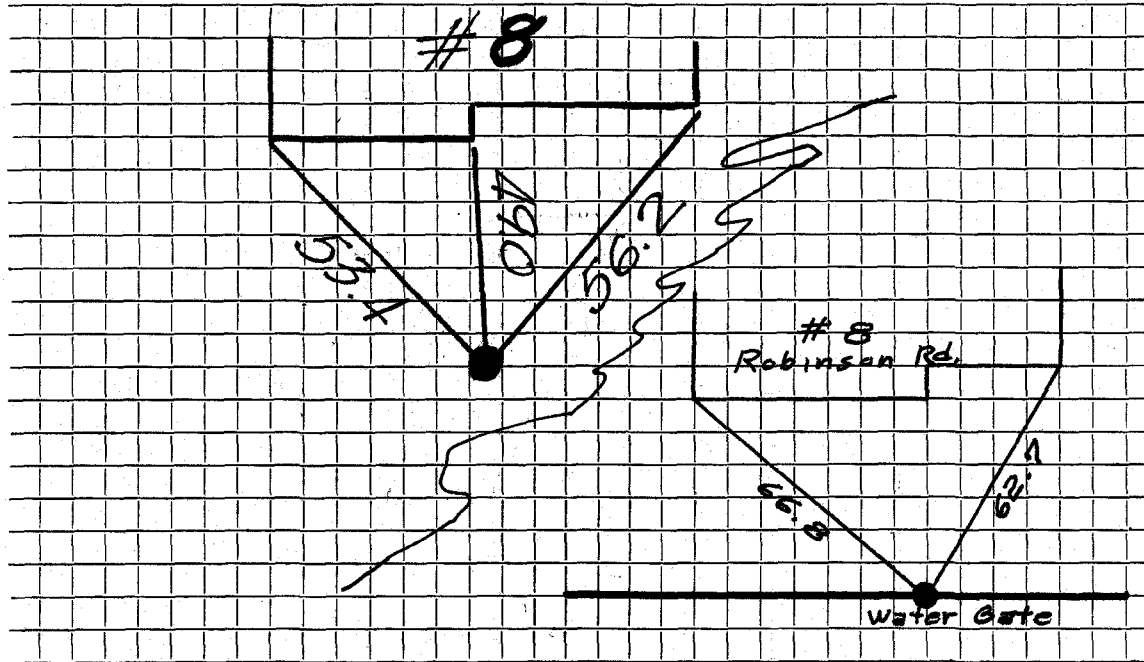

Connection made in Street. Work completed

Remarks:

.....

.....