


DATE _____

TOWN OF LEXINGTON — BOARD OF PUBLIC WORKS

WATER DIVISION

Sketch of Service Here

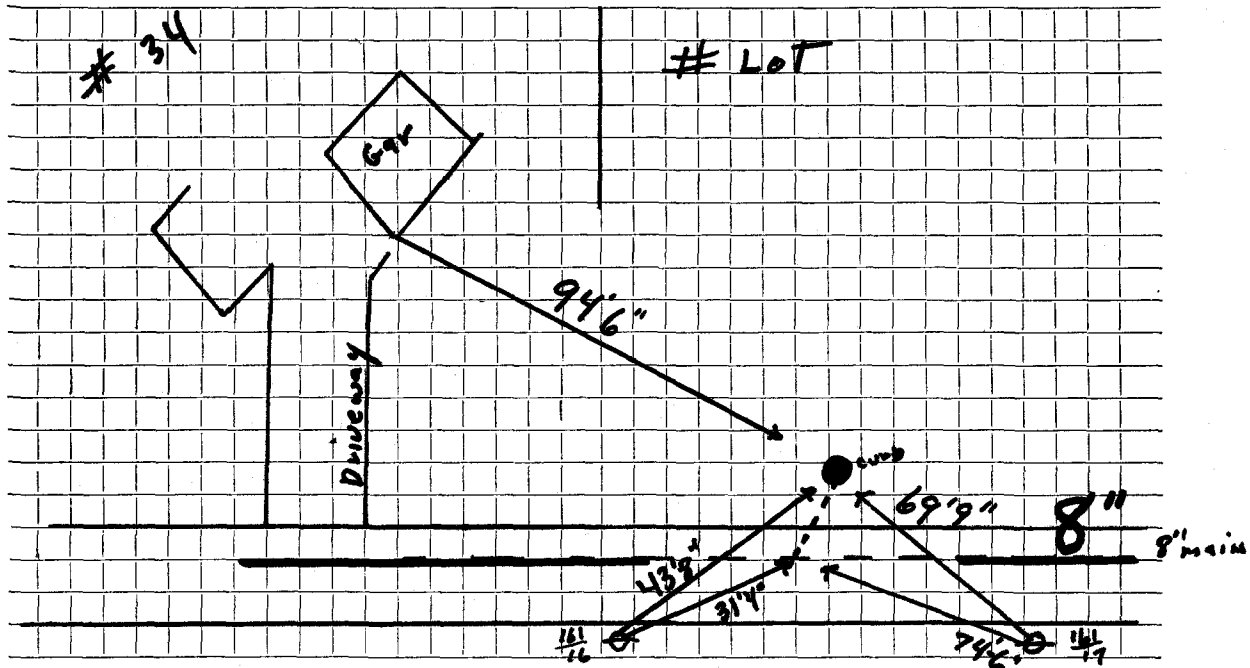

Connection made in Robinson Rd north of house 34 Street.

Work completed 7-28-90

Remarks: 1 3/4" Copper... Running left side of sewer