

## WATER SERVICE RECORD

587

Name Oscar Carlson

Service No. 372 (1956)

Address 24 /Rockville Avenue

Location

~~Repair Work~~ - New Service


Comm. 3/18/57

Date	Material	Amount	Total	Date	Amount
12-5-56	Labor	11.04		11-30-56	Deposit \$ 75.00
	10% O.H.	1.10	12.14	3-18-57	Refund \$ 19.93
1/6"	3/4" Copper tubing @ .4396		20.22		\$ 55.07
1	3/4" C x 1/2 I.W.H. Stop & Waste		4.96		NON CHARGE
1	hr. Trucking @ .75		.75	12-12-56	Labor 4.56
2	hrs. Littlefield @ 8.50		17.00	20'	3/4" Copper tubing @ .4396 8.79
			55.07	1	3/4" C Corp Cock 4.64
				1	3/4" C Curb Cock 5.94
				1	Box & Rod 4.62
				1	1/2 Straight tailpiece .50
				1	1/2 Offset tailpiece .50
				1	hr. Littlefield @ 8.50 8.50
					38.05

TOWN OF LEXINGTON — BOARD OF PUBLIC WORKS

WATER DIVISION

Sketch of Service Here

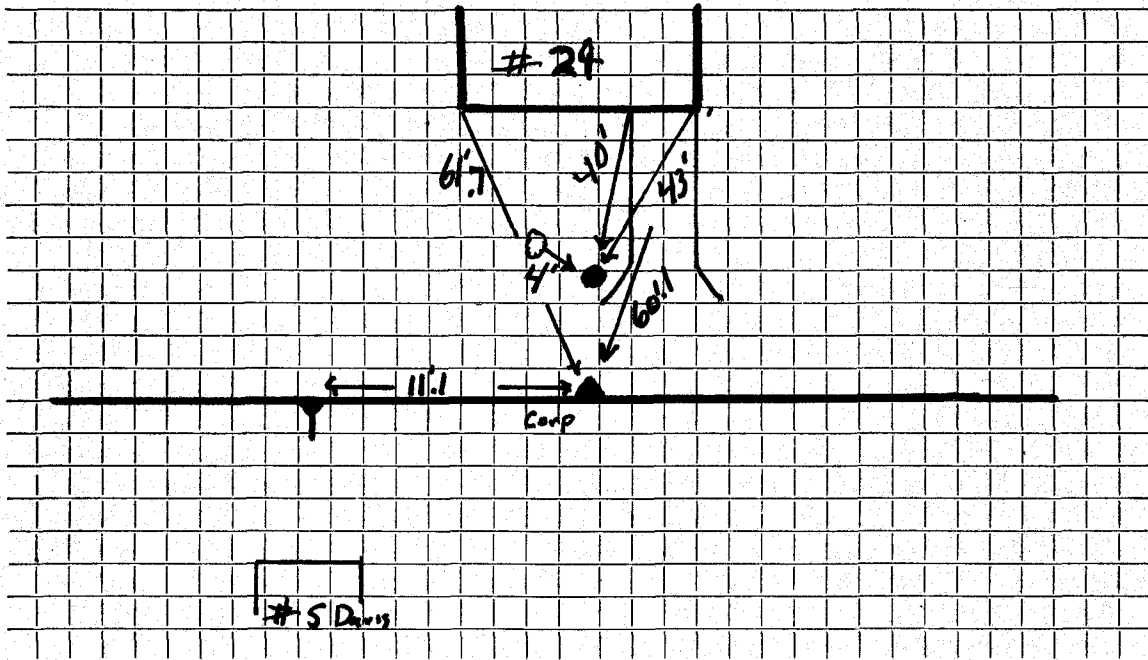

Connection made in ..... Street. Work completed .....

Remarks: .....

.....

.....