

## WATER SERVICE RECORD

# 613

Name Oscar Carlson

Service No. 373 (1956)

Address 26 Rockville Avenue

Location

~~XXXXXXXXXX~~ New Service


Comm. 3/18/57

Date	Material	Amount	Total	Date	Amount
12-5-56	Labor	11. 04		11-30-56	Deposit 75 00
	10% O.H.	1. 10	12.14	3-18-57	Refund 19 93
	40' 3/4" Copper tubing @ .4396		20.22		\$ 55 07
	1 3/4" C x 1/2 I.W.H. Stop & Waste		4.96		NON CHARGE
	1 hr. Trucking @ .75		.75	12-5-56	Labor 4. 56
	2 hrs. Littlefield @ 8.50		17.00		20' 3/4" Copper Tubing @ .4396 8. 79
			55.07		1 3/4" C Corp Cock 4. 64
					1 3/4" C Curb Cock 5. 94
					1 Box & Rod 4. 62
					1 1/2 Straight tailpiece .50
					1 1/2 Offset tailpiece .50
					1 hr Littlefield @ 8.50 8. 50
					38.05

TOWN OF LEXINGTON — BOARD OF PUBLIC WORKS

WATER DIVISION

Sketch of Service Here

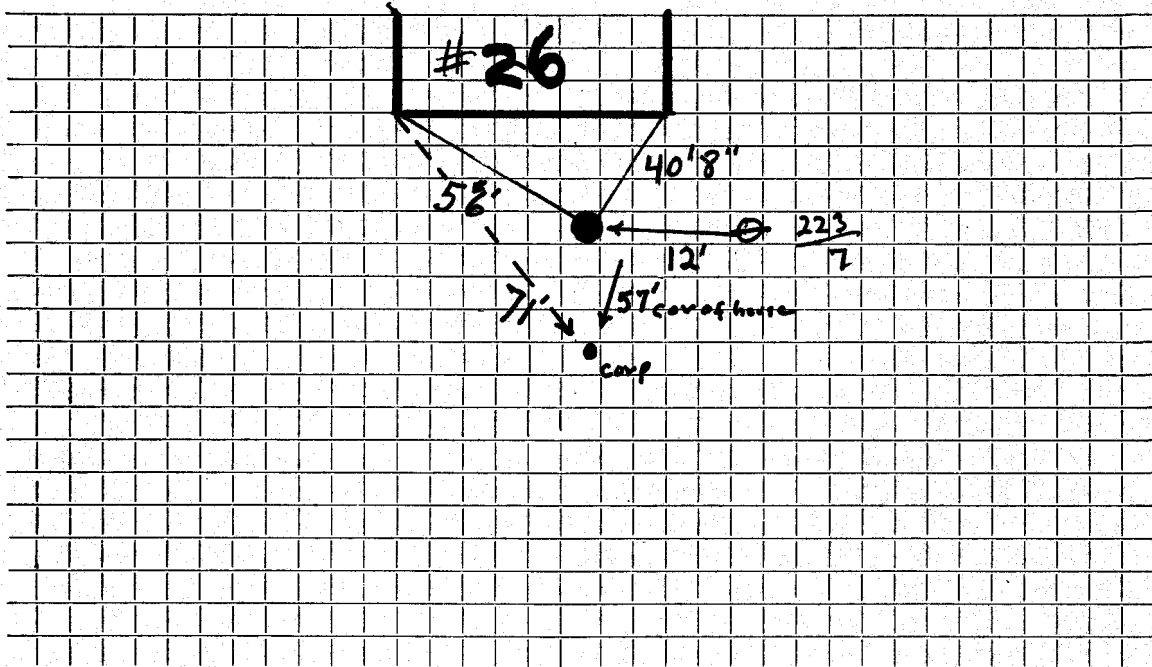

Connection made in ..... Street. Work completed .....

Remarks: .....

.....

.....