

WATER SERVICE RECORD

4162

Name Oscar Carlson

Service No. 85

Address 34 Rockville Avenue

Location

~~Repair~~ ~~Work~~ - New Service


Comm. 9-3-57

Date	Material	Amount	Total	Date	Amount
5/14/57	Labor	13 20		5-7-57	Deposit \$ 75 00
	10% overhead	1 32	14 52	7-3-57	Refund 24 15
	44' - 3/4" Copper tubing @ .4228	18 60			<u>NON CHARGE</u> 150 95
	1 - 3/4" Cx 1/2 I.W.H. Stop & Waste	4 96		Labor	8 76
	1 - 3/4" Union (3part)		2 27	29' - 3/4" Copper tubing @ .4228	12 26
	1 hr. trucking		75	1 - 3/4" C. Corp Cock	4 64
	1 1/2 hrs. Town shovel @ 6.50		9 75	1 - 3/4" C. Curb Cock	5 94
			50 85	1 Box & Rod	4 62
				1 - 1/2 Straight tailpiece	50
				1 - 1/2 Offset tailpiece	50
				1/2 hr. Town Shovel @ 6.50	3 25
					<u>40 47</u>

TOWN OF LEXINGTON — BOARD OF PUBLIC WORKS

WATER DIVISION

Sketch of Service Here

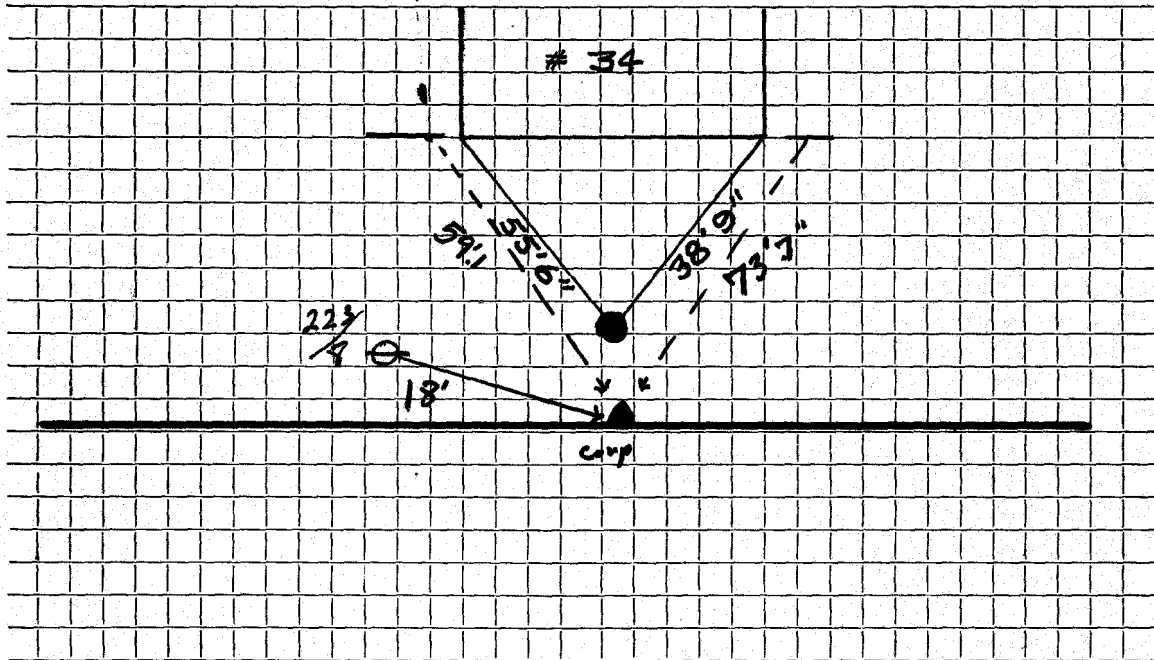

Connection made in Street. Work completed

Remarks:

.....

.....