


DATE _____

TOWN OF LEXINGTON — BOARD OF PUBLIC WORKS

WATER DIVISION

Sketch of Service Here

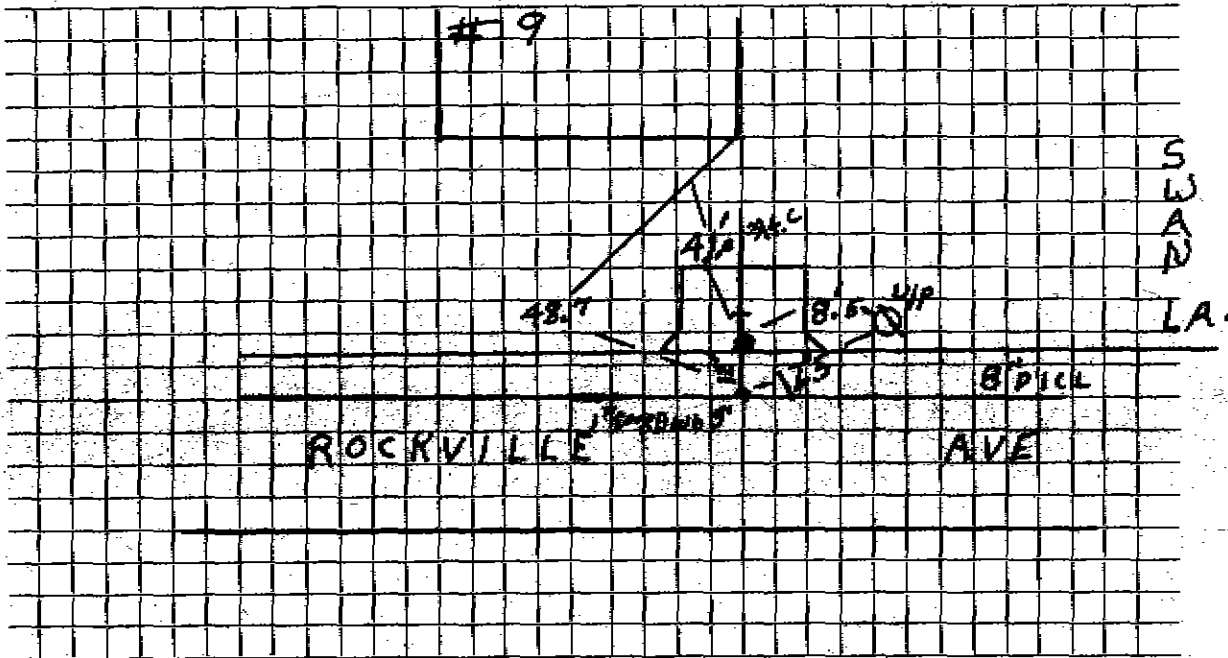

Connection made in Street.

Work completed 6/25/09 P.A.O.-Covp.

Remarks: Corp 5'0 Down - Curb 4'6