




DATE \_\_\_\_\_

TOWN OF LEXINGTON — BOARD OF PUBLIC WORKS

WATER DIVISION

Sketch of Service Here

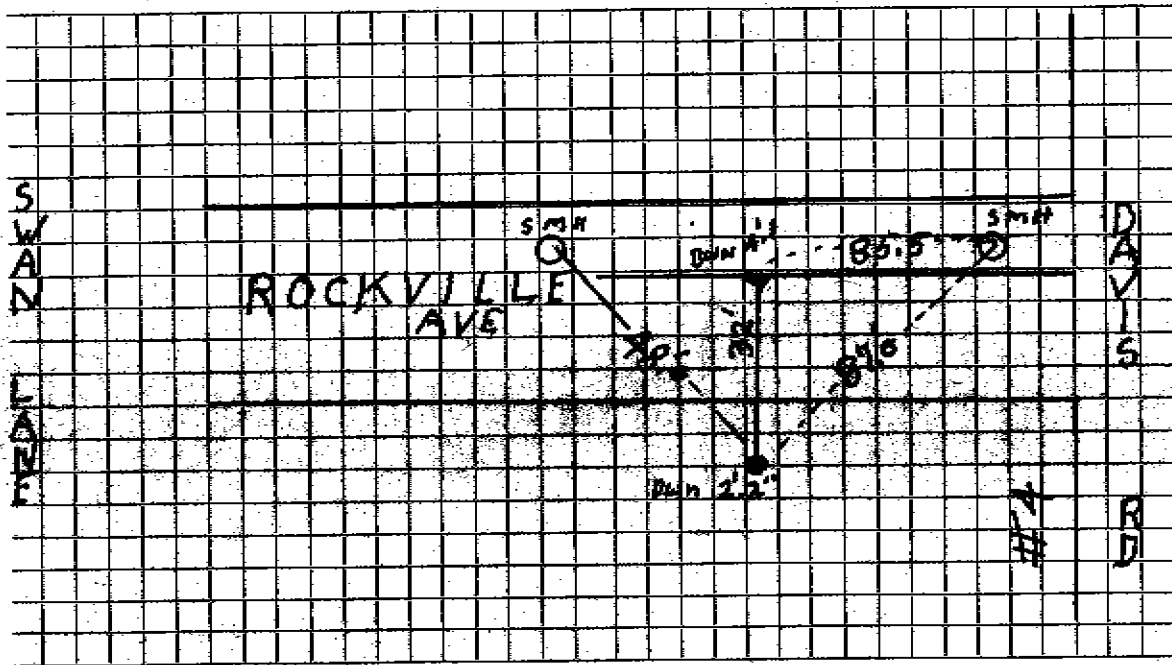

Connection made in ..... Street.

Work completed *P.A.O. Corp. 6/2/09*

Remarks: *Curb STOP. DWN. 2' 2"*