

WATER SERVICE RECORD

1211

Name Benjamin Franklin Homes

Service No. 182

Address 2 Rogers Road

Location Lot #9

~~Repair - Renewal~~ New Service

Comm 10-24-60


Date	Material	Amount	Total	Date		Amount
10-3-60	Labor	3.95		8-22-60	Deposit	50.00
	10% O.H.	.40	4.35	11-2-60	Paid	3.73
90'	3/4" Copper tubing @.42		37.80	11-28-60	Paid	32.15
1	3/4" C 3 part union		2.41		NON CHARGE	75.88
1	3/4" C x 1/2 I.W.H. Stop & Waste		6.17	1	1/2 Straight Tailpiece	.50
1	hr. Trucking @3.00		3.00	1	1/2 Offset tailpiece	.50
			53.73			1.00
	Charge for Labor		22.15			
			75.88			

Bill sent 11-7-60 22.15

Bill sent 11-24-60 3.73

TOWN OF LEXINGTON — BOARD OF PUBLIC WORKS
WATER DIVISION

Sketch of Service Here

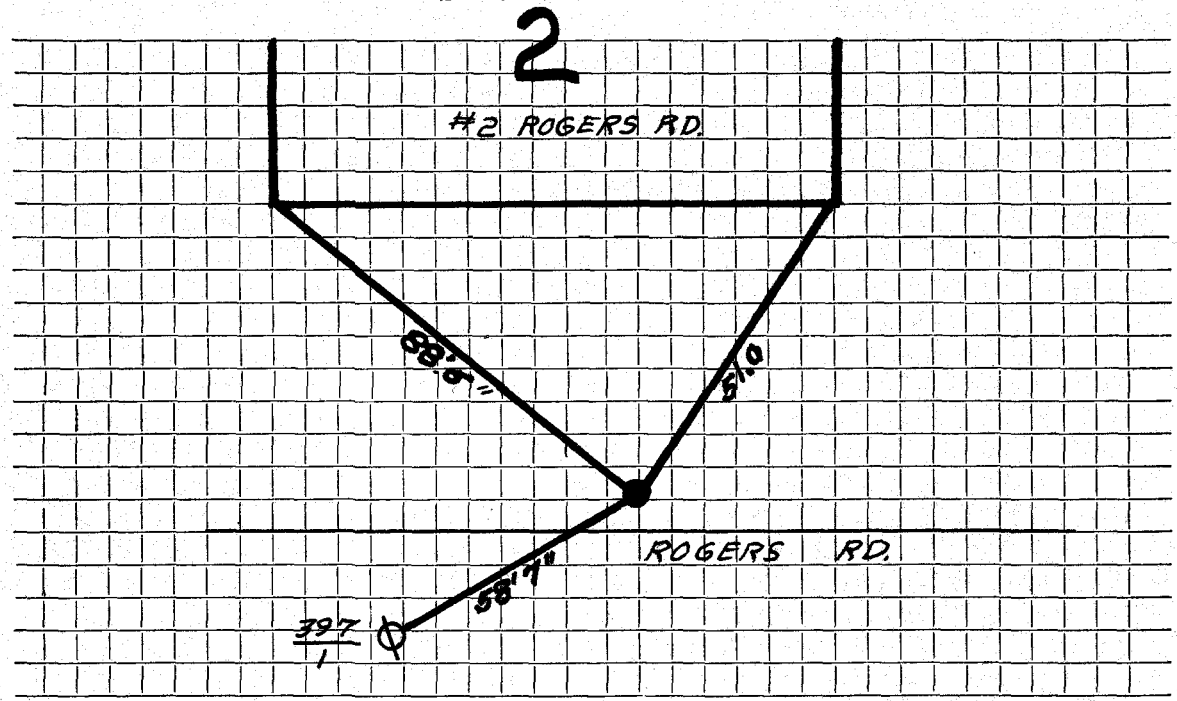

Connection made in Street. Work completed

Remarks:
.....
.....