

WATER SERVICE RECORD

#1669

Name Benjamin Franklin Homes

Service No. 20

Address 4 Rogers Road

Location

~~Repair - Renewal~~ - New Service


Committed 9-25-61

Date	Material	Amount	Total	Date	Amount
7-10-61	Labor	35.57		3-31-61	Deposit 80.00
	10% O.H.	3.56	39.13	9-25-61	Paid by W.H.C.#113 36.63
	58' 3/4" Copper tubing @.42		24.36		116.63
	1 3/4" x 1/2 I.W.H. Stop & Waste		6.17		NON CHARGE
CURB TO MAIN			69.66	1 1/2	Straight tailpiece .50
	14' 3/4" Copper tubing @.42		5.88	1 1/2	Offset tailpiece .50
	1 3/4" C Curb Cock		6.28		1.00
	1 3/4" C Corp Cock		4.91		
	1 Box & Rod		4.90		
	2 hrs. Pippin Shovel @5.00		10.00		
	1 hr. Trucking @3.00		3.00		
	12 x 3 Patch		12.00		
			116.63		

TOWN OF LEXINGTON — BOARD OF PUBLIC WORKS

WATER DIVISION

Sketch of Service Here

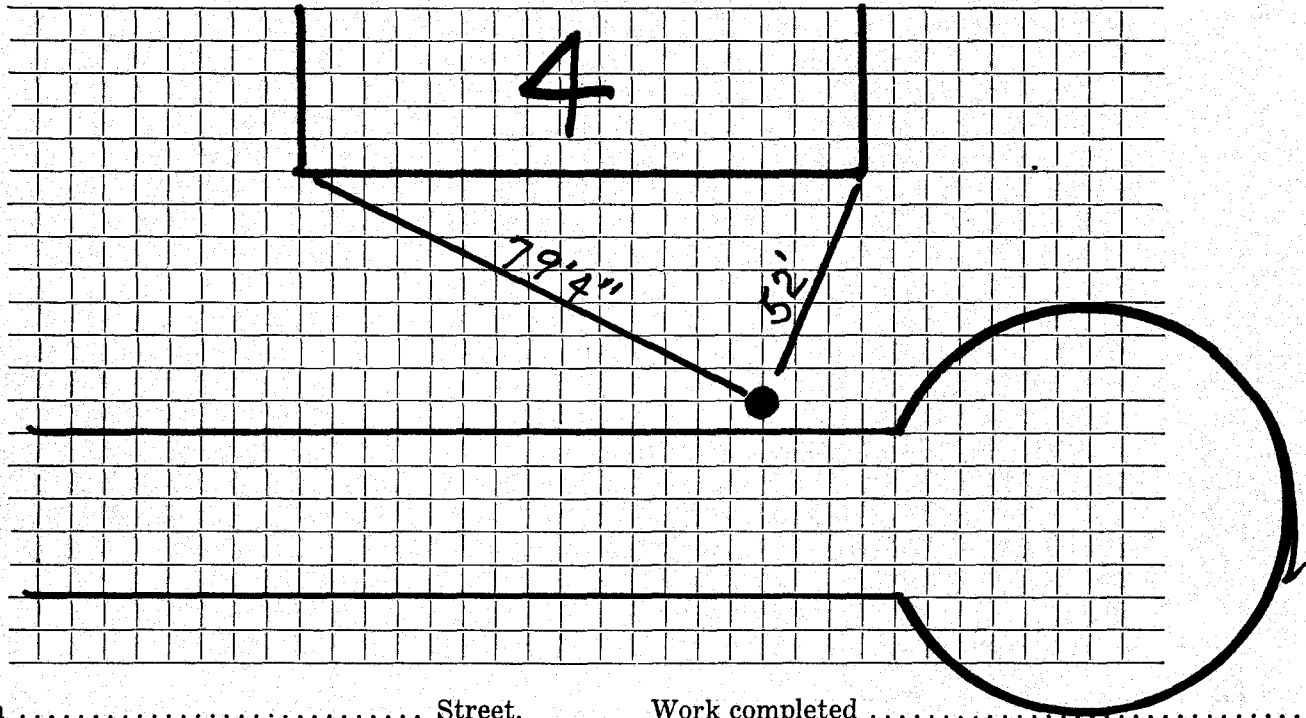

Connection made in Street. Work completed

Remarks:
.....
.....