

WATER SERVICE RECORD

Name Benjamin Franklin Homes

Service No. 312

Address 5 Rogers Road

Location Lot #12 Sta. 3+64


~~Repair~~ ~~Renewal~~ New Service

Comm 5-8-61

Date	Material	Amount	Total	Date		Amount
3-4-61	Labor	4.36		12-9-60	Deposit	80 00
	10% O.H.	.44	4.80	5-5-61	Pay	34 28
	70 ' 3/4" Copper tubing @.42		29.40			45 28
	1 3/4" C x 1/2 I.WH.Stop & Waste		6.17			
	1 3/4" C 3 part union		2.41		<u>Non Charge</u>	
	1 hr. Trucking @3.00		3.00	10-6-60	Labor	15 66
			45.78			
					54' 3/4" Copper tubing @12-22	68
					1 3/4" C Corp Cock	4 91
					1 3/4" C Curb Cock	6 28
					1 Box & Rod	4 90
						54 43
					1 1/2 Straight Tailpiece	50
					1 1/2 Offset tailpiece	50
						55.43

TOWN OF LEXINGTON — BOARD OF PUBLIC WORKS
WATER DIVISION

Sketch of Service Here #5

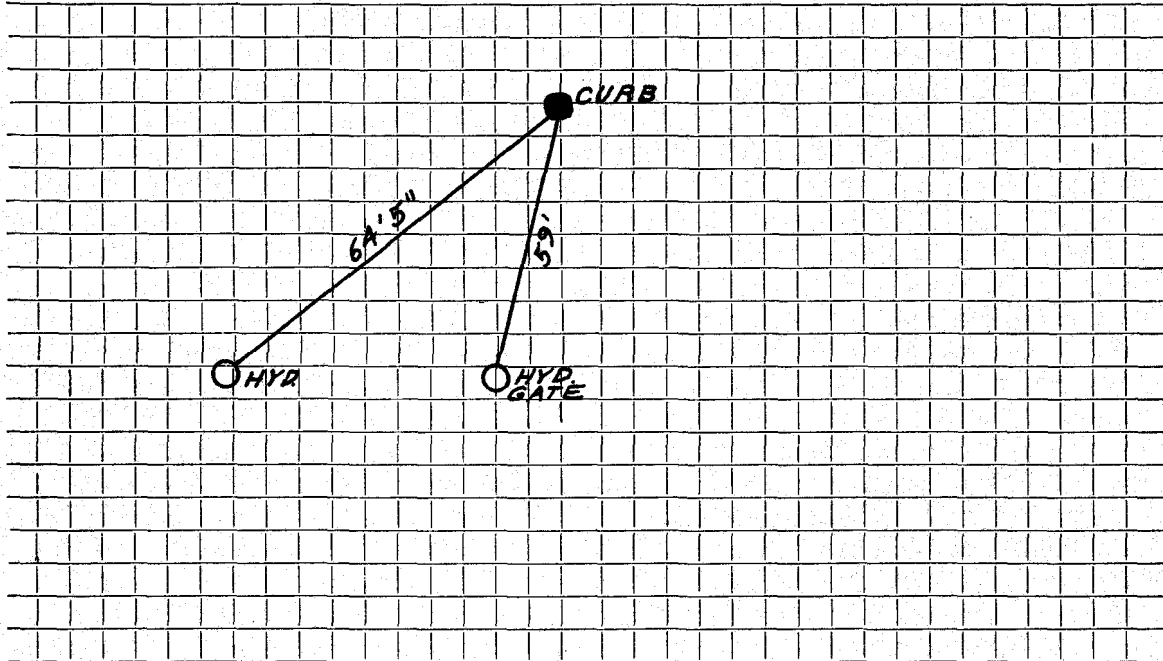

Connection made in Street. Work completed

Remarks:
.....
.....