

## WATER SERVICE RECORD

#5567

Name Benjamin Franklin Homes

Service No. 92

Address 3 Rolfe Road

Location Lot #29 Sta. 2144


~~Repaired~~ - New Service

Comm 9-25-61

Date	Material	Amount	Total	Date	Amount	
9-9-60	Labor	1 74		7-7-61	Deposit	100 00
	10% O.H.	17	1 91	9-25-61	Revised	26 00
	6' 3/4" Copper tubing @.12		2 52			73 98
	1 Hr. Trucking @3.00		3 00			
			7 43		NON CHARGE	
7-14-61	Labor	16.62		9-9-60	Labor	7 83
	10% O.H.	1.66	18.28	27'	3/4" Copper tubing @.12-11	34
	55' 3/4" Copper tubing @.42		23.10	1	3/4" CCurb Cock	6 28
	1 3/4" C x 1/2 I.W.H. Stop & Waste		6.17	1	3/4" C Corp Cock	4 91
	2 hrs. Trucking @3.00		6.00	1	Box & Rod	4 90
	2 hrs. Town Shovel @6.50		13.00			35 26
			73.98	1	1/2 Straight tailpiece	50
				1	1/2 Offset tailpiece	50
						36.26

TOWN OF LEXINGTON — BOARD OF PUBLIC WORKS  
**WATER DIVISION**

Sketch of Service Here

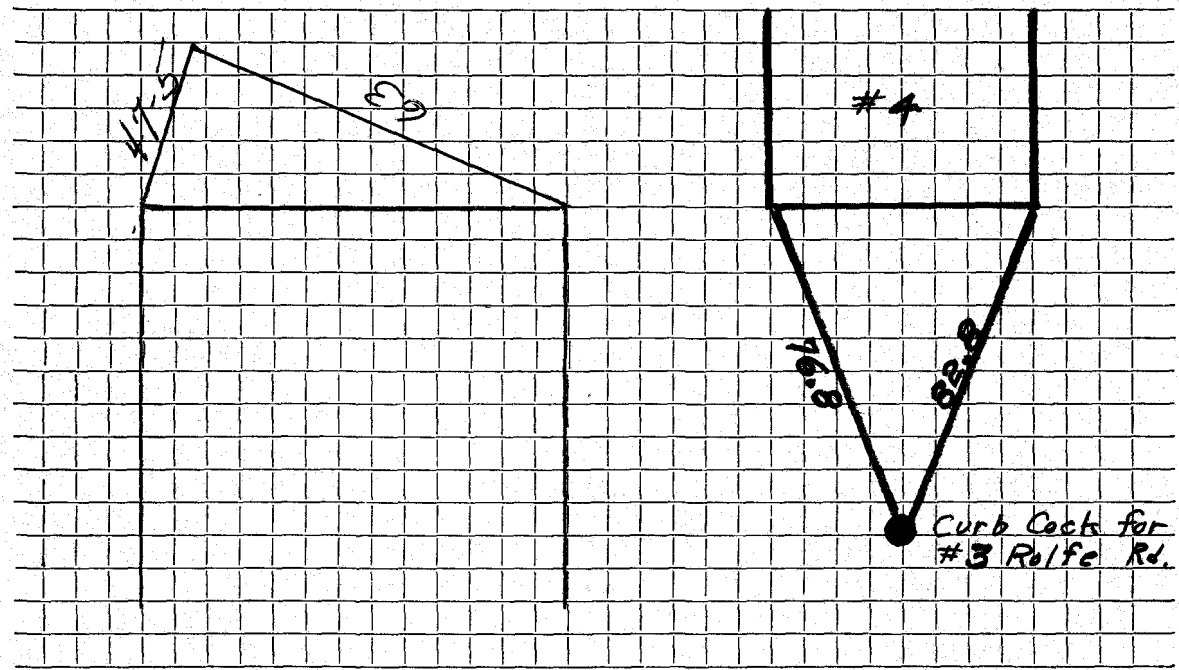

Connection made in ..... Street. Work completed .....

Remarks: .....  
.....  
.....