

WATER SERVICE RECORD

Name Benjamin Franklin Homes, Inc.

Service No. 21

Address 4 Rolfe Road

Location Lot #1 Sta. 243

~~Water Service~~ New Service

Comm 6-19-61


Date	Material	Amount	Total	Date	Amount	
9-9-60	Labor	3 48		3-31-61	Deposit	80 00
	10% O.H.	35	3 83	6-26-61	Paid	7 59
12'	3/4" Copper tubing @.12		5 04			87 59
1	Hr. Trucking @3.00		3 00			
			11 87		NON CHARGE	
6-3-61	Labor	31.58		9-9-60	Labor	3 48
	10% O.H.	3.16	34.74	12'	3/4" Copper tubing @.12	5 04
70'	3/8" Copper Tubing @.42		29.40	1	3/4" CCorp Cock	4 91
1	3/4" e x 1/2 I.W.H. Stop & Waste		6.17	1	3/4" CCurb Cock	6 28
1	3/4" e 3 part union		2.41	1	Box & Rod	4 90
1	Hr. Trucking @3.00		3 00			24 61
			87.59	6-6-61	1/2 Straight tailpiece	.50
					1/2 Offset tailpiece	.50
						25.61
				6-19-61	Bill sent	7.59

DATE _____

TOWN OF LEXINGTON — BOARD OF PUBLIC WORKS

WATER DIVISION

Sketch of Service Here

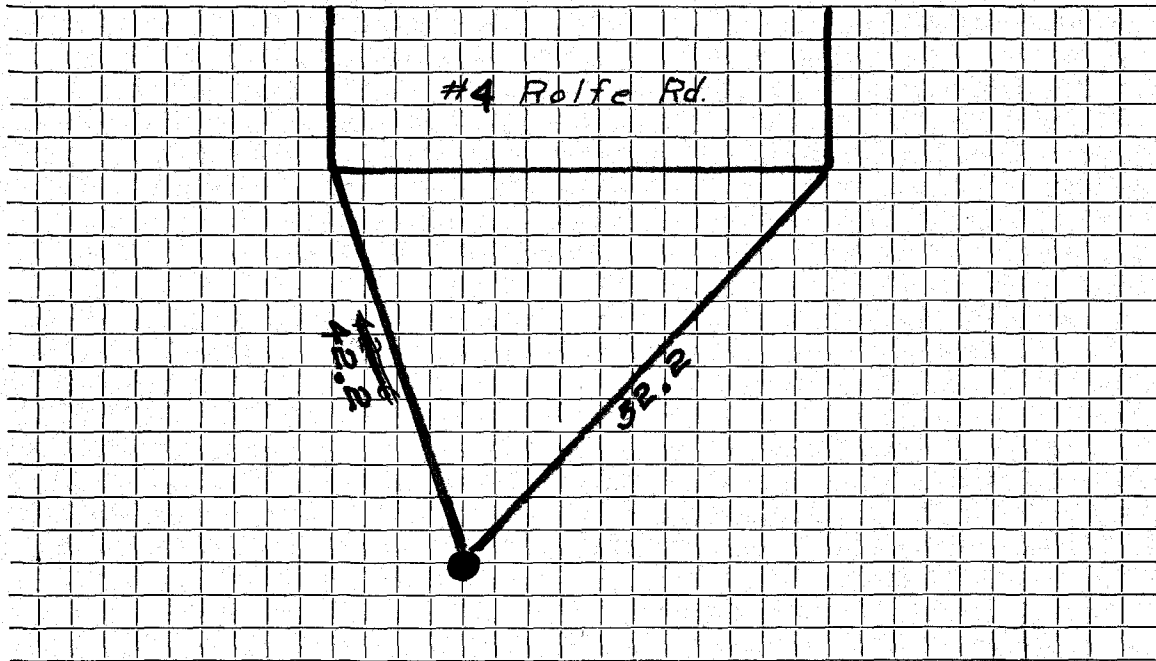

Connection made in Street. Work completed

Remarks:

.....

.....