

WATER SERVICE RECORD

Name Benjamin Franklin Homes

Service No. 277

Address 6 Rolfe Road

7623

Location Lot #2 Sta. 3+85

~~Renewal~~ New Service


Comm 3-6-61

Date	Material	Amount	Total	Date	Amount
9-9-60	Labor	5 22		11-18-60	Deposit 80 00
	10% O.H.	52	5 74	3-6-61	Paid by WPA # 275 5 53
	18' 3/4" Copper tubing @.42		7 56		85 53
	1 Hr. Trucking @3.00		3 00		
			16 30		NON CHARGE
12-8-60	Labor	3.76		9-9-60	Labor 1 64
	10% O.H.	.38	4.14	16'	3/4" Copper tubing @.42 6 72
	110' 3/4" Copper tubing @.42		46.20	1	3/4" C Corp Cock 1 91
	1 3/4" C x 1/2 I.W.H. Stop & Waste		6.17	1	3/4" C Curb Cock 6 28
	2 3/4" C 3 part unions @2.41		4.82	1	Box & Rod 1 90
	1 Curb Box & Rod		4.90		27 15
	1 hr. Trucking @.3000		3.00	1	1/2 Straight tailpiece .50
			85.53	1	1/2 Offset tailpiece .50
					28.45

TOWN OF LEXINGTON — BOARD OF PUBLIC WORKS

WATER DIVISION

Sketch of Service Here

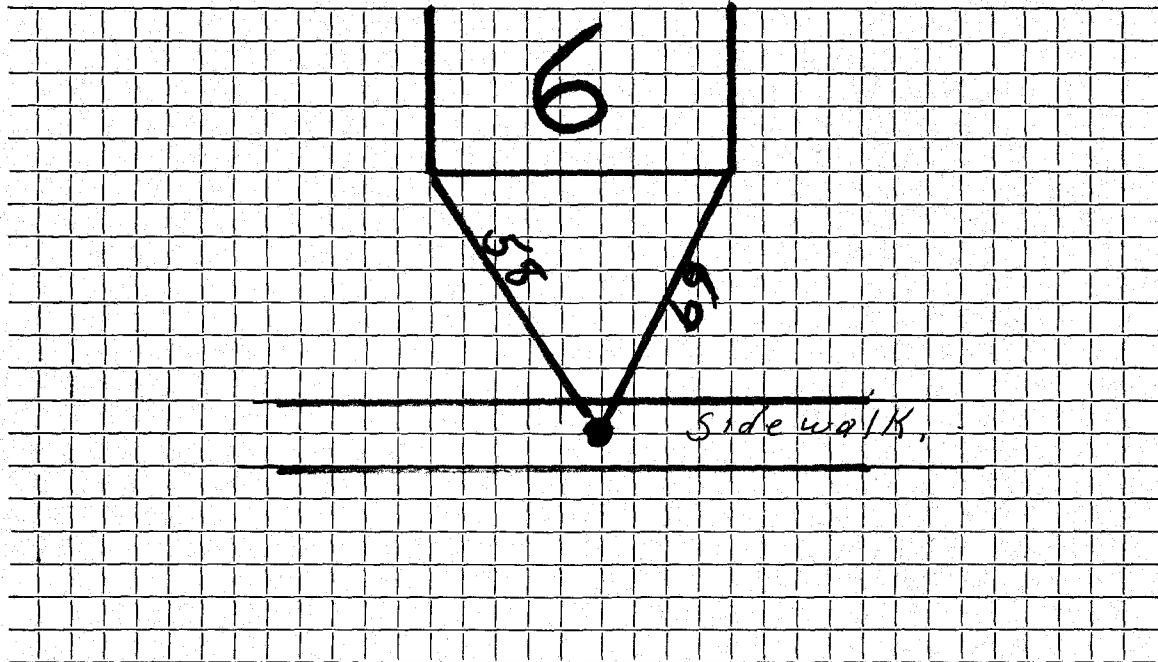

Connection made in Street. Work completed

Remarks:
.....
.....