

WATER SERVICE RECORD

Name Charles H. Murray

Service No. 96

Address ~~5100 Los Angeles Ave~~ 3 Rolling Lane

#5820, 5821

Location

Repair-Renewal-New Service

*Com 8-15-55*


Date	Material	Amount	Total	Date	Amount
6/9/55	Labor	1 85		4-15-55	25 00
	10% Overhead	19	2 04	8-15-55	(3 95)
	60' - 3/4" Copper tubing @ .3693	22 16			NON CHARGE
	1 - 3/4" Cx 1/2 I.W.H. stop & waste	4 00	4 00	6/9/55	28 95
	1 hr. trucking		75		
			28 95	21' - 3/4" Copper tubing @ .3693	7 76
				1 - 3/4" C. corp-cock	4 33
				1 - 3/4" c x 3/4" C. curb-cock	4 67
				1 box and rod	3 90
				1 - 1/2 straight tail piece	50
				1 - 1/2 offset tail piece	50
				1 hr. trucking	75
					24 26

DATE \_\_\_\_\_

# TOWN OF LEXINGTON — BOARD OF PUBLIC WORKS

## WATER DIVISION

Sketch of Service Here

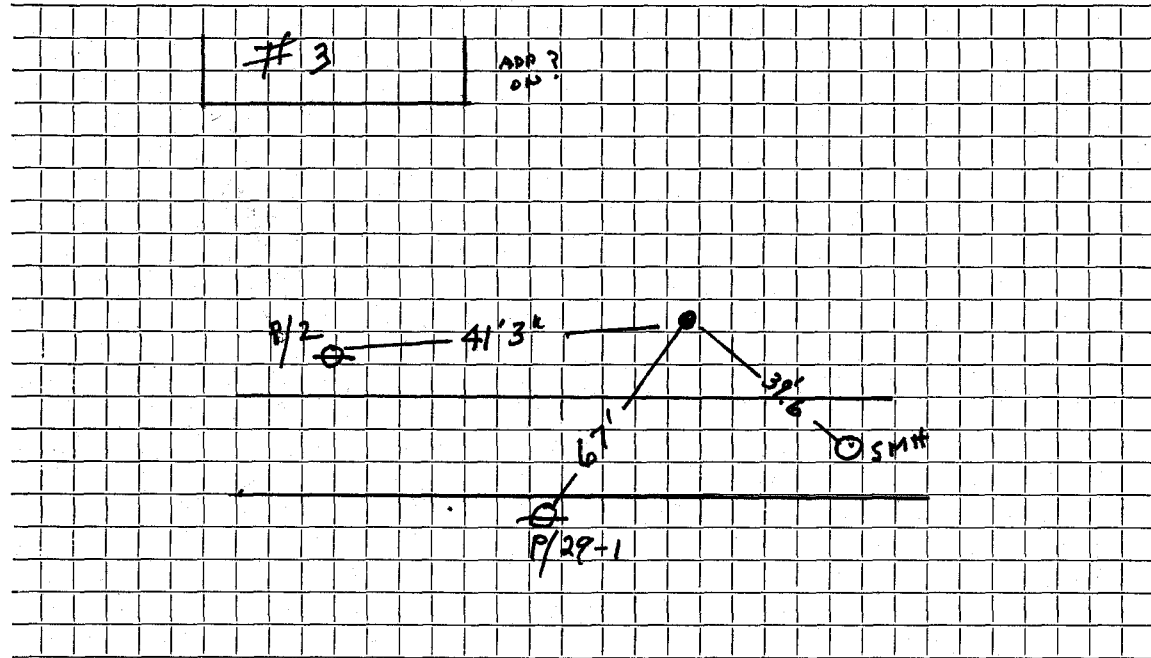

Connection made in ..... Street. Work completed .....

Remarks: .....

.....

.....