

## WATER SERVICE RECORD

#1960

Name Eric G. Sahlberg

Service No. 158

Address ~~7 Robinson Avenue~~ 7 Rolling Lane

Location

~~Repair~~ ~~Renewal~~ ~~New Service~~

Comm. 9/30/57


Date	Material	Amount	Total	Date	Amount
8/13/57	Labor	1 95		7-31-57	Deposit \$ 7500
	10% overhead	20	2 15	9-30-57	Refund 1964
	60' - 3/4" Copper tubing @ .375	22.50			NON CHARGE # 30.36
	1 - 3/4" Cx 1/2 I.W.H. Stop & Waste	4 96			Labor 3 52
	1 hr. Trucking		75		14' - 3/4" Copper tubing @ .375 5 25
			30 36		1 - 3/4" Corp Cock 4 64
					1 - 3/4" Curb Cock 5 94
					1 - 1/2" Straight tailpiece 50
					1 - 1/2" Offset tailpiece 50
					1 Box & Rod 4 62
					<u>24 97</u>

DATE \_\_\_\_\_

TOWN OF LEXINGTON — BOARD OF PUBLIC WORKS

WATER DIVISION

Sketch of Service Here

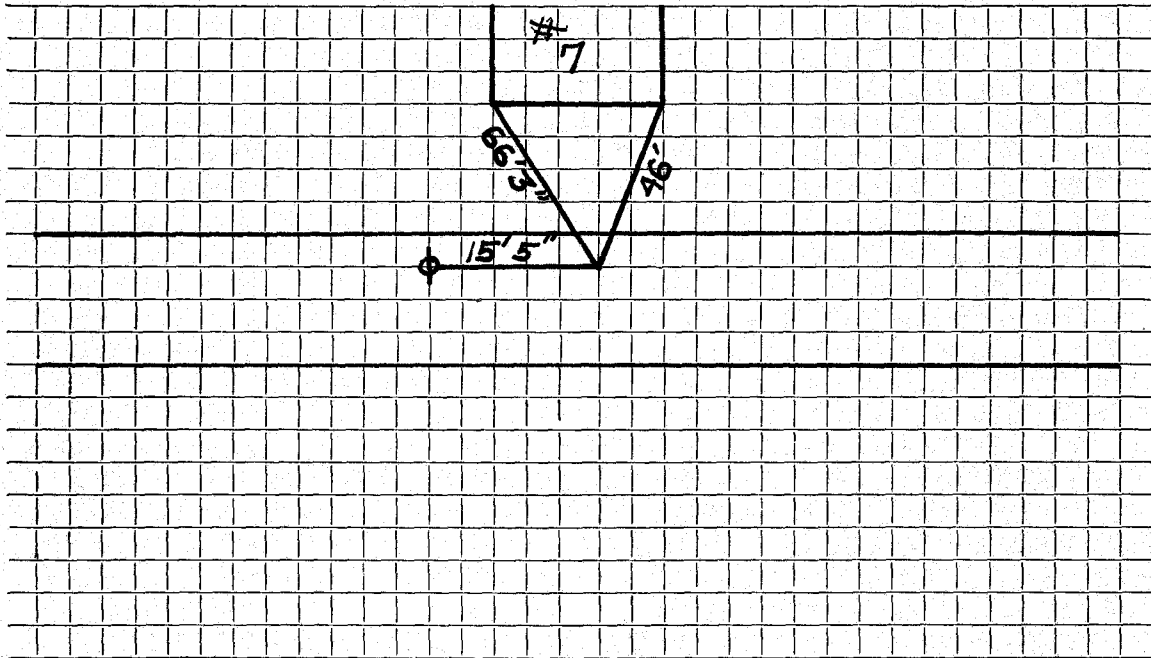

Connection made in ..... Street. Work completed .....

Remarks: .....

.....

.....