


DATE 8/4/17

TOWN OF LEXINGTON — BOARD OF PUBLIC WORKS
WATER DIVISION

Sketch of Service Here

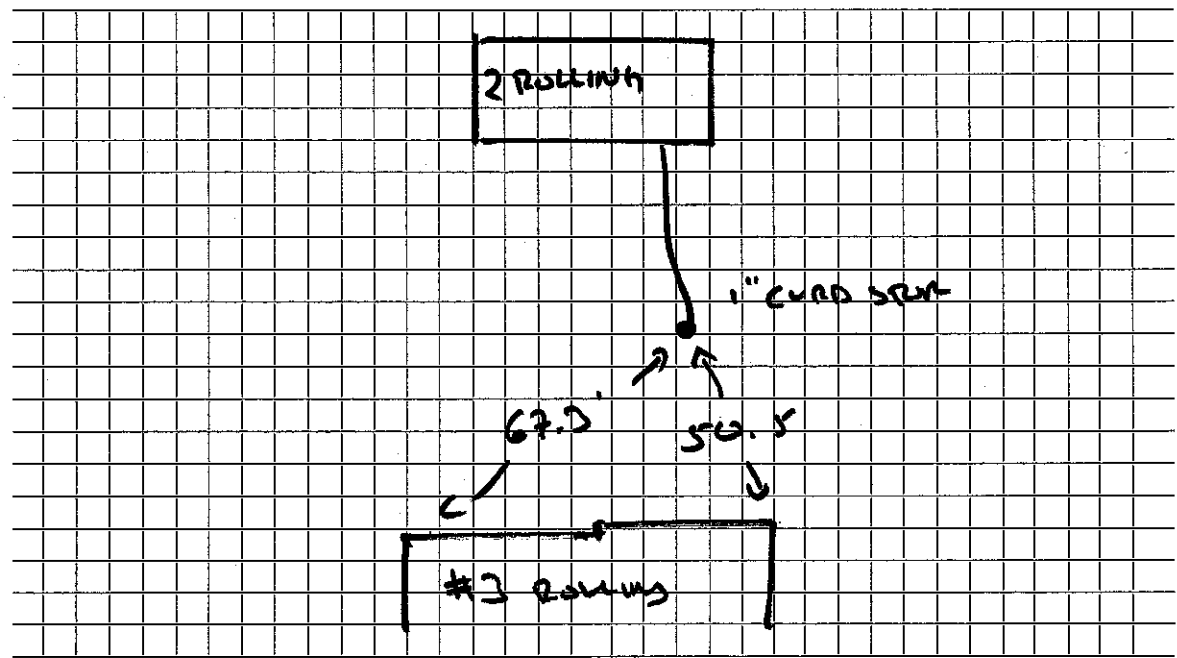

Connection made in Rollins Street. Work completed MCLAUGHLIN

Remarks: Service for 2 Rollins