

WATER SERVICE RECORD

261

Name Leeland Const. Co.

Service No. 171

Address 11 Roosevelt Road

Location

~~REPAIR SERVICE~~—New Service

Com. 8-30-54

Date	Material	Amount	Total	Date	Amount
7/22/54	Labor	1 85		7-16-54	Deposited 25 00
	10% overhead	19	2 04	9-14-54	Paid 2 79
	60' - 3/4" copper tubing@ .35		21 00		<u>NON CHARGE</u> 27 79
	1 - 3/4"C x 1/2 I.W.H. stop & waste	4 00	7/22/54	Labor	5 05
	1 hr. trucking		75	18' - 3/4" copper tubing@ .35	6 30
			27 79	1 - 3/4" C. corp-cock	4 33
	TRENCH DUG BY OWNER:			1 - 3/4"C. corp-cock	4 67
				1 box and rod	3 90
				1 - 1/2 straight tail piece	50
				1 - 1/2 offset tail piece	50
				1 hr. trucking	75
					<u>26 00</u>


Bill sent 8-30-54

DATE _____

TOWN OF LEXINGTON — BOARD OF PUBLIC WORKS

WATER DIVISION

Sketch of Service Here

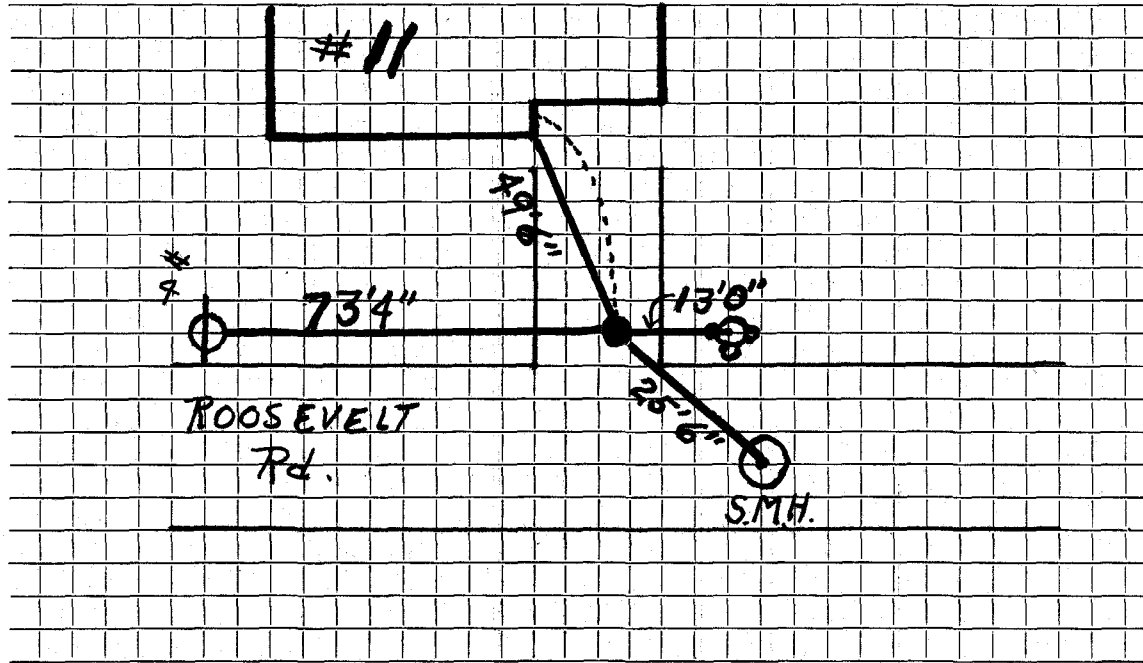

Connection made in Street. Work completed

Remarks:

.....

.....